


STATE OF KANSAS
STATE CORPORATION COMMISSION

WELL PLUGGING RECORD

Give All Information Completely
Mandatory Required Affidavit
Mail or Deliver Report to:
Conservation Division
State Corporation Commission
800 Bitting Building
Wichita, Kansas

NORTH

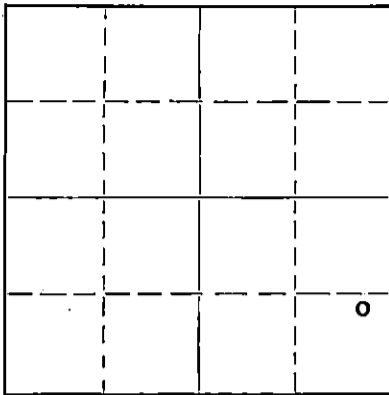

Locate well correctly on above
Section Plat

Reho..... County. Sec. 28 Twp. 24 Rge. 5 (E) W (W)
Location as "NE/CNW $\frac{1}{4}$ SW $\frac{1}{4}$ " or footage from lines NE $\frac{1}{4}$ SE $\frac{1}{4}$ SE $\frac{1}{4}$
Lease Owner The Drillers Gas Company
Lease Name W. Yoder Well No. 2
Office Address 903 Union National Bldg., Wichita 2, Kansas
Character of Well (completed as Oil, Gas or Dry Hole) Gas well
Date well completed July 24 1944
Application for plugging filed July 13 1950
Application for plugging approved July 14 1950
Plugging commenced July 26 1950
Plugging completed July 29 1950
Reason for abandonment of well or producing formation Ceased producing gas
If a producing well is abandoned, date of last production July 1950
Was permission obtained from the Conservation Division or its agents before plugging was commenced? Yes

Name of Conservation Agent who supervised plugging of this well Ruel Durkee
Producing formation..... Depth to top..... Bottom..... Total Depth of Well 3,431 Feet
Show depth and thickness of all water, oil and gas formations.

OIL, GAS OR WATER RECORDS

CASING RECORD

Formation	Content	From	To	Size	Put In	Pulled Out
Mississippi		3,391		8 5/8"	498'	0
				5 1/2"	3,393	2,490'

Describe in detail the manner in which the well was plugged, indicating where the mud fluid was placed and the method or methods used in introducing it into the hole. If cement or other plugs were used, state the character of same and depth placed, from.....feet to.....feet for each plug set.

Plugged back with crushed rock 3,431 to 3,390

Dumped 6 sacks cement

Pulled 2,490' 5" of 5 1/2" casing

Mudded hole to 250'

Set 10' rock bridge w/ 15 sacks cement

Mudded hole to 30'

Cement bridge 10 sacks

RECEIVED

Conservation Div.

AUG 7 - 1950

STATE CORPORATION
COMMISSION
KANSAS

8-7-50

(If additional description is necessary, use BACK of this sheet)

Correspondence regarding this well should be addressed to The Drillers Gas Company
Address 903 Union National Bldg., Wichita 2, Kansas

STATE OF KANSAS, COUNTY OF SEDGWICK, ss.
M. R. Schwartzkopf (employee of owner) or (owner or operator) of the above-described well,
being first duly sworn on oath, says: That I have knowledge of the facts, statements, and matters herein contained and the log of the above-described well as filed and that the same are true and correct. So help me God.

(Signature) M. R. Schwartzkopf
903 Union National Bldg., Wichita 2, Kansas
(Address)

SUBSCRIBED AND SWORN to before me this 5th day of August, 1950.

Betha E. Wilson

Notary Public.

My commission expires August 13, 1951

PLUGGING
FILE SEC...
PAGE 4 LINE 17

Yoder No. 2 Well *Yoder Field*

NE SE SE Sec. 28-24S-5W,
Reno County, Kansas.

Drilled for: Drillers Gas Company
Drilled by: Beardmore Drilling Company

Casing Record:

10-3/4 O.D. 155'
8-5/8 O.D. 498'
5-1/2 O.D. 3393'

Drilling Commenced: June 30, 1944.
Drilling Completed: July 24, 1944.

<u>FORMATION</u>	<u>DEPTH</u>
surface	155
shale & shells	503
shale	545
shale & shells	760
shale & lime	1080
sand	1075
lime	1080
lime (broken)	1120
sand	1140
lime (broken)	1160
shale & lime	1600
shale & shells	1860
lime	1925
lime (broken)	2145
lime	2520
shale	2658
lime	2745
lime (broken)	2790
lime	2835
lime (broken)	2885
lime	3160
shale & lime	3350
shale	3380
shale & lime	3394
Miss. lime	3428 T.D.

STATE OF KANSAS
SS.
COUNTY OF SEDGWICK

I, the undersigned, being duly sworn on oath, state that the above and within statement is a true and correct record and log of the well drilled on the location above described, to the best of my knowledge and belief.

W. J. Aldner

Subscribed and sworn to before me this 3rd day of August, 1944.

Jane E. Macauley
Notary Public

My Commission Expires:
December 22, 1947

Elevation 1538

PLUGGING RECEIVED
Conservation Div.
AUG 31 1950
STATE CORPORATION COMMISSION KANSAS
7-31-50
FILE DEC. 28. 7. 24. 1950
BOOK PAGE 16 LINE 17