


WELL PLUGGING RECORD

Give All Information Completely
Make Required Affidavit
Mail or Deliver Report to:
Conservation Division
State Corporation Commission
211 No. Broadway
Wichita, Kansas

Reno County. Sec. 28 Twp. 24S Rge. 5W (E)____(W)____

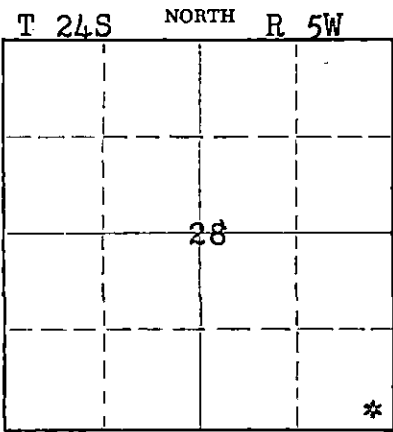

Locate well correctly on above
Section Plat

Location as "NE/CNWxSWx" or footage from lines SE SE SE
Lease Owner Drillers Production Co., Inc.
Lease Name Willie Yoder Well No. 1
Office Address Insurance Bldg. - Wichita, Kansas
Character of Well (completed as Oil, Gas or Dry Hole) _____
Date well completed _____ 19____
Application for plugging filed _____ 19____
Application for plugging approved _____ 19____
Plugging commenced April 26 1957
Plugging completed April 30 1957
Reason for abandonment of well or producing formation _____

If a producing well is abandoned, date of last production _____ 19____
Was permission obtained from the Conservation Division or its agents before plugging was commenced? Yes

Name of Conservation Agent who supervised plugging of this well Ruel Durkee
Producing formation _____ Depth to top _____ Bottom _____ Total Depth of Well 3423 Feet
Show depth and thickness of all water, oil and gas formations.

OIL, GAS OR WATER RECORDS

CASING RECORD

FORMATION	CONTENT	FROM	TO	SIZE	PUT IN	PULLED OUT
				9-5/8"	500'	None
				6-5/8"	3396'	2488'

Describe in detail the manner in which the well was plugged, indicating where the mud fluid was placed and the method or methods used in introducing it into the hole. If cement or other plugs were used, state the character of same and depth placed, from _____ feet to _____ feet for each plug set.

Filled the hole with sand from 3423' to 3385' and ran 6 sacks of cement. Mudded the hole to 400', set a 10' rock bridge and ran 20 sacks of cement. Mudded the hole to 20', set a 5' rock bridge and ran 6 sacks of cement which filled to the base of the cellar. Plugging completed.

(If additional description is necessary, use BACK of this sheet)

Name of Plugging Contractor West Supply Co., Inc.
Address Chase, Kansas

STATE OF Kansas, COUNTY OF Sedgwick, ss. _____ (employee of owner) or (owner of well) of the above-described well, being first duly sworn on oath, says: That I have knowledge of the facts, statements, and matters herein contained and the log of the above-described well as filed and that the same are true and correct. So help me God.

(Signature) [Signature]
208 Insurance Bldg., 212 N. Market, Wichita, Kans.
(Address)

SUBSCRIBED AND SWORN to before me this 9th day of May, 1957

Bertha L. Wilson
Notary Public.

My commission expires August 13, 1959

RECEIVED
STATE CORPORATION COMMISSION

PLUGGING
FILE SEC. 28 T. 24 R. 5W
BOOK PAGE 146 LINE 13

MAY 13 1957 5-10-57
CONSERVATION DIVISION
WICHITA, KANSAS

DRILLERS GAS CO.,
W.D. Yoder No. 1.

SEC. 28 T. 24 R. 5W.
SEC SE

Total Depth. 3403.
Comm. 3-25-38 Comp. 4-16-38
Shot or Treated.
Contractor. Springrose Drilg. Co.
Issued. 7-9-38

County Reno.

CASING.

95/8" 500' 65/8" 3400'

Elevation.

Production. 15,100,000 gas.

Figures Indicate Bottom of Formations.

surface	25	lime	2905
sand and clay	75	shale and lime	2910
red rock and gyp	85	sdv lime soft	2922
red shale and gyp	108	lime broken	2960
shale and shells	160	lime	2990
shale gyp and shells	320	broken lime	3010
shale	400	sdv lime soft	3022
shale and gyp	435	lime	3025
shale and shells	485	broken lime	3100
shale and lime shells	500	lime	3115
broken lime	555	lime and shale	3150
shale and salt	670	shale	3190
anhydrite	695	broken lime	3215
shale lime gyp and shells	815	shale lime & shells	3250
broken lime	1160	shale	3390 $\frac{1}{2}$
lime	1205	chat	3403
lime and shale	1345		
shale and shells	1450	Total Depth.	
shale and lime shells	1670		
shale and lime	1915		
shale and shells	2010		
broken lime	2110		
lime	2130		
broken lime	2300		
lime	2330		
shale	2365		
broken lime	2495		
shale lime shells	2560		
shale and water sand	2610		
shale and shells	2655		
lime	2845		
broken lime	2870		

PLUGGING
FILE SEC. 28 T. 24 R. 5W
BOOK PAGE 146 LINE 13

RECEIVED
STATE CORPORATION COMMISSION

MAY 10 1957 5-10-57

CONSERVATION DIVISION
Wichita, Kansas.