


STATE OF KANSAS
STATE CORPORATION COMMISSION

WELL PLUGGING RECORD

Give All Information Completely
Make Required Affidavit
Mail or Deliver Report to
Conservation Division
State Corporation Comm.
245 North Water
Wichita, KS 67202

Reno County, Sec. 12 Twp. 24S Rge. 7W E/W
Location as "NE/CNW 1/4 SW 1/4" or footage from lines C SE SE
Lease Owner Sanders Oil Company
Lease Name Haskard Well No. #1
Office Address 910 Sutton Place, Wichita, Kansas
Character of Well (Completed as Oil, Gas or Dry Hole) Dry Hole
Date Well completed 12-15-79 19
Application for plugging filed 12-15-79 19
Application for plugging approved 12-15-79 19
Plugging commenced 12-15-79 19
Plugging completed 12-15-79 19
Reason for abandonment of well or producing formation

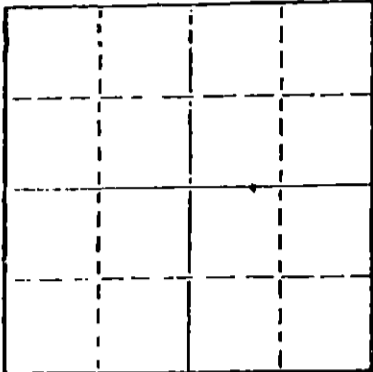

Locate well correctly on above Section Plot

If a producing well is abandoned, date of last production 19
Was permission obtained from the Conservation Division or its agents before plugging was commenced? Yes

Name of Conservation Agent who supervised plugging of this well Gilbert Toman
Producing formation Depth to top Bottom Total Depth of Well 4125
Show depth and thickness of all water, oil and gas formations.

OIL, GAS OR WATER RECORDS				CASING RECORD		
FORMATION	CONTENT	FROM	TO	SIZE	PUT IN	PULLED OUT
Surface		0	247'	8 5/8"	247'	0

Describe in detail the manner in which the well was plugged, indicating where the mud fluid was placed and the method or methods used in introducing it into the hold. If cement or other plugs were used, state the character of same and depth placed, from feet to feet for each plug set.

50 sx @ 350'
13 sx @ 40'
2 sx in rathole

(If additional description is necessary, use BACK of this sheet)

Name of Plugging Contractor Brandt Drilling Co., Inc.

STATE OF Kansas COUNTY OF Sedgwick, ss.
Timothy E. Brandt (employee of owner) or (owner or operator)
of the above-described well, being first duly sworn on oath, says: That I have knowledge of the facts, statements, and matters herein contained and the log of the above-described well as filed and that the same are true and correct. So help me God.

(Signature) [Signature]
1104 Douglas Bldg., Wichita, Kansas
(Address)

SUBSCRIBED AND SWORN TO before me this 19th day of December, 1979

[Signature] Notary Public.

My commission expires 1-24-82

RECEIVED
STATE CORPORATION COMMISSION

JAN 1 1 1980
1-11-80
CONSERVATION DIVISION
Wichita, Kansas



**WELL COMPLETION REPORT AND
DRILLER'S LOG**

API No. 15 — 155 — 20,617
County Number

S. 12 T. 24S R. 7W E
W
Loc. C SE SE
County Reno

Operator Sanders Oil Company

Address 910 Sutton Place, Wichita, Kansas


Well No. #1 Lease Name Haskard

Footage Location 660 feet from (N) (S) line 660 feet from (E) (W) line

Principal Contractor Brandt Drilling Co., Inc. Geologist

Spud Date 12-7-79 Date Completed 12-15-79 Total Depth 4125 P.B.T.D.

Directional Deviation Oil and/or Gas Purchaser

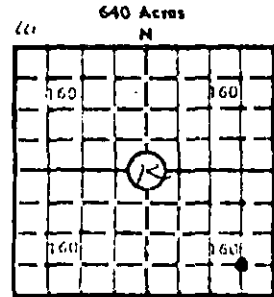

Locate well correctly
Elev.: Gr. 1581
DF 1583 KB 1585

CASING RECORD

Report of all strings set — surface, intermediate, production, etc.

Purpose of string	Size hole drilled	Size casing set (in O.D.)	Weight lbs/ft.	Setting depth	Type cement	Sacks	Type and percent additives
Surface	12 1/4"	8 5/8"	24#	247'	Common	225	2% gel; 3% cacl

LINER RECORD

PERFORATION RECORD

Top, ft.	Bottom, ft.	Sacks cement	Shots per ft.	Size & type	Depth interval

TUBING RECORD

Size	Setting depth	Packer set at

ACID, FRACTURE, SHOT, CEMENT SQUEEZE RECORD

Amount and kind of material used	Depth interval treated

INITIAL PRODUCTION

Date of first production	Producing method (flowing, pumping, gas lift, etc.)				
RATE OF PRODUCTION PER 24 HOURS	Oil	Gas	Water	Gas-oil ratio	
	bbls.	MCF	bbls.	CFPB	
Disposition of gas (vented, used on lease or sold)			Producing interval (s)		

INSTRUCTIONS: As provided in KCC Rule 82-2-125, within 90 days after completion of a well, one completed copy of this Drillers Log shall be transmitted to the State Geological Survey of Kansas, 4150 Monroe Street, Wichita, Kansas 67209. Copies of this form are available from the Conservation Division, State Corporation Commission, 245 No. Water, Wichita, Kansas 67202. Phone AC 316-522-2206. If confidential custody is desired, please note Rule 82-2-125. Drillers Logs will be on open file in the Oil and Gas Division, State Geological Survey of Kansas, Lawrence, Kansas 66044.

15-155-20617-0000

DESIGNATE TYPE OF COMP.: OIL, GAS, DRY HOLE, SWDW, ETC.: dry hole

Operator Sanders Oil Company

Well No. #1 Lease Name Haskard

S 19 T 4S R 13E W C SE SE Reno County

WELL LOG

Show all important zones of porosity and contents thereof; cored intervals, and all drill-stem tests, including depth interval tested, cushion used, time tool open, flowing and shut-in pressures, and recoveries.

SHOW GEOLOGICAL MARKERS, LOGS RUN, OR OTHER DESCRIPTIVE INFORMATION.

FORMATION DESCRIPTION, CONTENTS, ETC.	TOP	BOTTOM	NAME	DEPTH
Sand	0	110		
Red Rock	110	115		
Shale	115	150		
Shale maroon	150	185		
Lime	185	205		
Shale	205	400		
Red rock	400	450		
Shale & salt	450	750		
Shale & lime	750	850		
Salt	850	1000		
Sandy shale	1000	1440		
Lime and shale streaks	1440	1650		
Sand	1650	1660		
Shale and Sand	1660	1805		
Lime and shale streaks	1805	1940		
Sand	1940	1960		
Lime and shale	1960	2100		
Shale	2100	2120		
Lime chalky	2120	2500		
Shale	2500	2530		
Lime fossil chalky	2530	2861		
Shale black (Heebner)	2861	2868		
Lime and Shale	2868	3048		
Lime xln fossil (Lansing)	3048	3592		
Shale and sandy shale	3592	3714		
Chert and cherty lime (Miss)	3714	3838		
Dolomite lime (Viola)	3838	4090		
Sand Rounded clean (Sp)	4090	4100		
Dolomite	4100	4120		
RTD	4120	4125		

USE ADDITIONAL SHEETS, IF NECESSARY, TO COMPLETE WELL RECORD.

Date Received

Signature: *[Handwritten Signature]*

Title: General Manager

Date: 12-19-79