

STATE OF KANSAS
STATE CORPORATION COMMISSION

WELL PLUGGING RECORD

Give All Information Completely
Make Required Affidavit
Mail or Deliver Report to:
Conservation Division
State Corporation Commission
211 No. Broadway
Wichita, Kansas

Edwards County, Sec. 35 Twp. 25 Rge. 16 (X) (W)

Location as "NE/CNW/SW" or footage from lines SE SE NW

Lease Owner L. C. Smitherman

Lease Name Mayhew Well No. 4

Office Address Box 627 - Augusta, Kansas

Character of Well (completed as Oil, Gas or Dry Hole) Dry Hole

Date well completed Jan. 14 19 59

Application for plugging filed Jan. 14 19 59

Application for plugging approved Jan. 14 19 59


Plugging commenced Jan. 14 19 59

Plugging completed Jan. 14 19 59

Reason for abandonment of well or producing formation Dry hole

If a producing well is abandoned, date of last production 19

Was permission obtained from the Conservation Division or its agents before plugging was commenced? yes

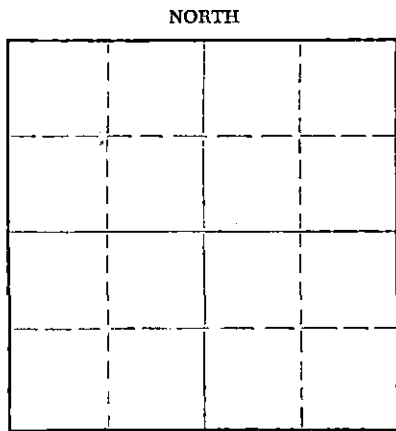

Locate well correctly on above Section Plat

Name of Conservation Agent who supervised plugging of this well Frank Broadfoot

Producing formation Depth to top Bottom Total Depth of Well 4457 Feet

Show depth and thickness of all water, oil and gas formations.

OIL, GAS OR WATER RECORDS

CASING RECORD

FORMATION	CONTENT	FROM	TO	SIZE	PUT IN	PULLED OUT
		0	359	8 5/8"	359'	none

Describe in detail the manner in which the well was plugged, indicating where the mud fluid was placed and the method or methods used in introducing it into the hole. If cement or other plugs were used, state the character of same and depth placed, from feet to feet for each plug set.

Plug set at 250' - cement with 25 sacks to 30'
Plug set at 30' - cement to top

RECEIVED
STATE CORPORATION COMMISSION
FEB 18 1959
2-18-59
CONSERVATION DIVISION
Wichita, Kansas

(If additional description is necessary, use BACK of this sheet)
Name of Plugging Contractor L. C. Smitherman Drilling Co.
Address Box 627 - Augusta, Kansas

STATE OF KANSAS, COUNTY OF BUTLER, ss.
Carl J. Lehr (employee of owner) or (owner/operator) of the above-described well, being first duly sworn on oath, says: That I have knowledge of the facts, statements, and matters herein contained and the log of the above-described well as filed and that the same are true and correct. So help me God.

(Signature) Carl J. Lehr
Box 627 - Augusta, Kansas (Address)

SUBSCRIBED AND SWORN TO before me this 17th day of February, 19 59

Shirley Ann Jackson
Shirley Ann Jackson Notary Public.

My commission expires January 28, 1961

PLUGGING
FILE SEC 35 T 25 R 16W
BOOK PAGE 13 LINE 28

MAYHEW #4

COMPANY: L. C. Smitherman - Oil Producer
 CONTRACTOR: L. C. Smitherman Drilling Co.

Location: SE SE NW, Sec. 35-25-16,
 Edwards Co., Kansas

Commenced: December 29, 1958
 Completed: January 13, 1959

Elevation: 2061 DF
 Casing: 259' - 8 5/8" cem. W/275 sks.

FIGURES INDICATE BOTTOMS OF FORMATIONS:


0	100	Sand & Shells
100	215	Sand
215	220	Post Rock
220	258	Shale
258	415	Shale & Shells
415	610	Red Bed
610	900	Shale & Shells
900	1020	Shale & Sand
1020	1033	Anhydrite
1033	1175	Shale
1175	1770	Shale & Shells
1770	2040	Shale
2040	2160	Shale & Lime
2160	2550	Lime
2550	2635	Shale
2635	3130	Shale & Lime
3130	3528	Lime
3528	3865	Lime & Shale
3865	3907	Lime
3907	3995	Lime & Shale
3995	4164	Lime
4164	4389	Lime & Shale
4389	4390	Lime
4390	4445	Shale
4445	4457	Shale & Chert
4457		TOTAL DEPTH

We hereby certify the above and foregoing to be a true and correct copy of the Log on the Mayhew #4, located in the SE SE NW, Section 35-25-16, Edwards County, Kansas.

L. C. SMITHERMAN DRILLING COMPANY


 Carl J. Lehr

Subscribed and sworn to before me this 17th day of February, 1959.

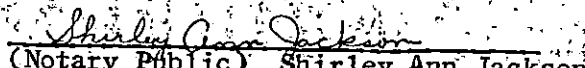
 (Notary Public) Shirley Ann Jackson

My Commission expires January 28, 1961.

RECORDED
 STATE CORPORATE COMMISSION

FEB 18 1959

CONSERVATION DIVISION
 Wichita, Kansas

PLUGGING

FILE SEC 35 T. 25 R. 16W

BOOK PAGE 13 LINE 20