


15-047-20341-000

STATE OF KANSAS
STATE CORPORATION COMMISSION

WELL PLUGGING RECORD

Give All Information Completely
Make Required Affidavit
Mail or Deliver Report to
Conservation Division
State Corporation Comm.
245 North Water
Wichita, KS 67202

Edwards County, Sec. 5 Twp. 26S Rge. 17W E/W
Location as "NE/CNW 1/4 SW 1/4" or footage from lines
1650' FSL & 990' FEL NE/4
Lease Owner Murfin Drilling Company
Lease Name Mayhew-Greer Well No. 1-5
Office Address 617 Union Center, Wichita, Kansas 67202
Character of Well (Completed as Oil, Gas or Dry Hole)

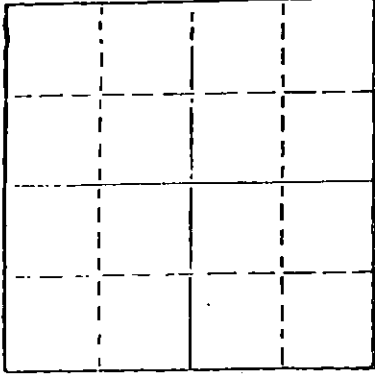

Locate well correctly on above
Section Plat

Dry hole
Date Well completed March 12, 1978
Application for plugging filed March 12, 1978
Application for plugging approved March 12, 1978
Plugging commenced March 12, 1978
Plugging completed March 12, 1978
Reason for abandonment of well or producing formation
dry hole

If a producing well is abandoned, date of last production 19

Was permission obtained from the Conservation Division or
its agents before plugging was commenced? yes

Name of Conservation Agent who supervised plugging of this well Bill Owens
Producing formation Depth to top Bottom Total Depth of Well 4700
Show depth and thickness of all water, oil and gas formations.

OIL, GAS OR WATER RECORDS

CASING RECORD

FORMATION	CONTENT	FROM	TO	SIZE	PUT IN	PULLED OUT
				8-5/8"	294'	--

Describe in detail the manner in which the well was plugged, indicating where the mud fluid
was placed and the method or methods used in introducing it into the hold. If cement or other
plugs were used, state the character of same and depth placed, from feet to
feet for each plug set.

Mud to 540', 40 sacks cement
Mud to 300, 35 sacks cement
Mud to 40, plug, 1/4 sack hulls, 12 sacks cement
3 sacks cement in rat hole

RECEIVED
STATE CORPORATION COMMISSION

MAR 22 1978 3-22-78

CONSERVATION DIVISION
Wichita, Kansas

(If additional description is necessary, use BACK of this sheet)

Name of Plugging Contractor

STATE OF KANSAS COUNTY OF SEDGWICK, ss.
Dorothy M. Mikish (employee of owner) or ~~owner or operator~~
of the above-described well, being first duly sworn on oath, says: That I have knowledge of
the facts, statements, and matters herein contained and the log of the above-described well
as filed and that the same are true and correct. So help me God.

(Signature) Dorothy M. Mikish
Suite 250, 200 West Douglas, Wichita, Kansas
(Address)

SUBSCRIBED AND SWORN TO before me this 21st day of March, 1978

Kathleen L. Durbin
Kathleen L. Durbin Notary Public.

My commission expires January 4, 1981

