


Give All Information Completely
Make Required Affidavit
Mail or Deliver Report to:
Conservation Division
State Corporation Commission
800 Bittling Building
Wichita, Kansas

15-185-00467-0000
WELL PLUGGING RECORD

NORTH

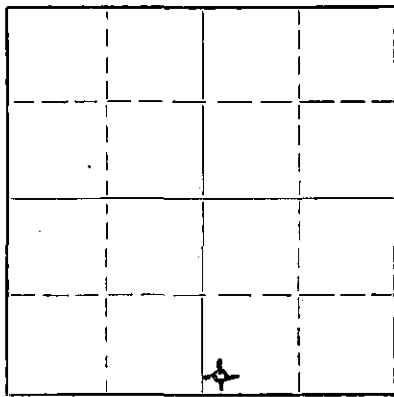

Locate well correctly on above
Section Plat

Stafford County, Sec. 23 Twp. 25S Rge. (E) 12 (W)
Location as "NE/CNW/SW" or footage from lines SW $\frac{1}{4}$ - SW $\frac{1}{4}$ - SE $\frac{1}{4}$
Lease Owner Champlin Refining Company
Lease Name Glen A. Helmer Well No. 1
Office Address P.O. Dr. #552, Enid, Oklahoma
Character of Well (completed as Oil, Gas or Dry Hole) Dry Hole
Date well completed January 4, 19 54
Application for plugging filed January 12, 19 54
Application for plugging approved January 12, (Verbal) 19 54
Plugging commenced January 13, 19 54
Plugging completed January 16, 19 54
Reason for abandonment of well or producing formation _____

If a producing well is abandoned, date of last production _____ 19 ____
Was permission obtained from the Conservation Division or its agents before plugging was commenced? Yes

Name of Conservation Agent who supervised plugging of this well M. A. Rives
Producing formation _____ Depth to top _____ Bottom _____ Total Depth of Well 3643 ^{PBTD} Feet
Show depth and thickness of all water, oil and gas formations.

OIL, GAS OR WATER RECORDS

CASING RECORD

FORMATION	CONTENT	FROM	TO	SIZE	PUT IN	PULLED OUT
				10 3/4" OD	320'	None
				7" OD	4087'	2906'

Describe in detail the manner in which the well was plugged, indicating where the mud fluid was placed and the method or methods used in introducing it into the hole. If cement or other plugs were used, state the character of same and depth placed, from _____ feet to _____ feet for each plug set.

Plugged back with crushed rock from 3643' PBTD to 3620' and set cement plug using 5 sacks cement using dump bailer leaving top of cement at 3595' then pumped in 40 sacks of mud and 150 sacks of cement leaving cement in hole from 291' to bottom of cellar.

RECEIVED
STATE CORPORATION COMMISSION
JAN 23 1954
CONS. DIV.
WICHITA, KANSAS
1-23-54

(If additional description is necessary, use BACK of this sheet)
Name of Plugging Contractor Miller Casing Pulling Company
Address Great Bend, Kansas

STATE OF Kansas, COUNTY OF Barton, ss.
S. P. Hall (employee of owner) or (owner of property) of the above-described well, being first duly sworn on oath, says: That I have knowledge of the facts, statements, and matters herein contained and the log of the above-described well as filed and that the same are true and correct. So help me God.

(Signature) S. P. Hall
P.O. Box 167, Ellinwood, Kansas
(Address)

SUBSCRIBED AND SWORN to before me this 22nd day of January 1954

My commission expires Sept. 10, 1955 M. Kenneth Stevens Notary Public.

PLUGGING
FILE SEC 23-25-124
BOOK PAGE 7 LINE 22

CHAMPLIN REFINING COMPANY
 Glen A. Helmer #1
 SW $\frac{1}{4}$ SW $\frac{1}{4}$ SE $\frac{1}{4}$
 Sec. 23 T25s R12w
 Stafford County, Kansas

0 - 322	Sand and Shale
332 - 773	Red Bed and Sand
773 - 1145	Shale and sand
1145 - 1405	Shale and sand
1405 - 1412	Anhydrite
1412 - 1605	Shale
1605 - 1810	Shale, sand and anhydrite
1810 - 1890	Shale, sand and lime
1890 - 2055	Shale, sand and lime
2055 - 2140	Shale and sand
2140 - 2305	Shale, sand and lime
2305 - 2450	Shale and Lime
2450 - 2584	Shale lime and sand
2584 - 3244	Shale and lime
3244 - 3355	Shale, sandy lime and lime
3355 - 3427	Shale and lime
3427 - 3553	Lime, sand and shale
3553 - 3643	Shale and lime
3643 - 3833	Lime
3833 - 3880	Lime and shale
3880 - 3979	Lime
3979 - 4014	Lime and shale
4014 - 4019	Lime
4019 - 4049	Lime and chert
4049 - 4086	Chert and lime
4086 - 4111	Chert, Dolomite and lime
4111 - 4132	Lime, shale and chert
4132 - 4150	Shale and lime
4150 - 4167	Shale and sand
4167 - 4212	Shale and sand
4212 - 4230	Shale and lime
4230	Rotary Total Depth
3643	PBTD

FILED
 COMMISSION

JAN 14 1954

STATION DIVISION
 Wichita, Kansas

1-14-54

PLUGGING
 FILE SEC 23 T25 R12W
 BOOK PAGE 7 LIT 32