


STATE OF KANSAS
STATE CORPORATION COMMISSION

WELL PLUGGING RECORD

Give All Information Completely
Make Required Affidavit
Mail or Deliver Report to
Conservation Division
State Corporation Comm.
245 North Water
Wichita, KS 67202

Stafford County. Sec. 21 Twp. 25S Rge. 12W
Location as "NE/CNW $\frac{1}{4}$ SW $\frac{1}{4}$ " or footage from lines

C - NE SW SW
Lease Owner Decker Petroleum, Inc.
Lease Name Henderson Well No. 1
Office Address P.O. BOX 352, Canton, Kansas 67428
Character of Well (Completed as Oil, Gas or Dry Hole)

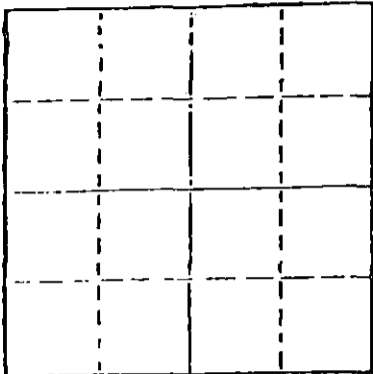

Locate well correctly on above
Section Plat

Dry Hole
Date Well completed June 16, 1978
Application for plugging filed Verbal Application 19
Application for plugging approved Verbal Approval 19
Plugging commenced June 16, 1978
Plugging completed June 16, 1978
Reason for abandonment of well or producing formation

If a producing well is abandoned, date of last production 19

Was permission obtained from the Conservation Division or its agents before plugging was commenced? Yes

Name of Conservation Agent who supervised plugging of this well Wm. T. Owen
Producing formation Depth to top Bottom Total Depth of Well 4,220
Show depth and thickness of all water, oil and gas formations.

OIL, GAS OR WATER RECORDS				CASING RECORD			
FORMATION	CONTENT	FROM	TO	SIZE	PUT IN	PULLED OUT	
		6-26-78		8-5/8"	324'	None	

Describe in detail the manner in which the well was plugged, indicating where the mud fluid was placed and the method or methods used in introducing it into the hold. If cement or other plugs were used, state the character of same and depth placed, from feet to feet for each plug set.

Filled hole with heavy rotary mud from 4,220 ft. (rotary total depth) to 540 ft. Set plug at 540 ft. and cemented with 40 sacks cement. Filled hole with heavy rotary mud from 540 ft. to 330 ft. Set plug at 330 ft. and cemented with 35 sacks cement. Filled hole with heavy rotary mud from 330 ft. to 40 ft. Set solid plug at 40 ft. and cemented to cellar with 12 sacks cement, 3 sacks cement in rat hole.

Plugging operations accomplished utilizing Halliburton Oil Well cementing pump truck through 4 1/2 inch drill pipe.

(If additional description is necessary, use BACK of this sheet)

Name of Plugging Contractor Halliburton Services
410 Union Center Bldg., Wichita, Kansas 67202

STATE OF Kansas COUNTY OF Sedgwick, ss.
Dean Britting, Agent (employee of owner) or (owner or operator)

of the above-described well, being first duly sworn on oath, says: That I have knowledge of the facts, statements, and matters herein contained and the log of the above-described well as filed and that the same are true and correct. So help me God.

(Signature) Dean Britting
200 N. Main, Wichita, Kansas 67202
(Address)



SUBSCRIBED AND SWORN TO before me this 23rd day of June, 1978

Elsie Willison - Notary Public.
My commission expires June 30, 1978

KANSAS DRILLERS LOG

COMPANY Decker Petroleum, Inc.

SEC. 21 T. 25S R. 12W
LOC. C - NE SW SW

FARM Henderson NO. 1

COUNTY Stafford

ROTARY TOTAL DEPTH 4,220'
COMM. June 5, 1978
CONTRACTOR H-30, Inc.
ISSUED June 23, 1978

COMP. June 16, 1978

CASING

10 3/4"
8 5/8" Set at 324' cemented w/275 sxs cement
5 1/2"
4 1/2"

ELEVATION 1,868 OR.

FIGURES INDICATE BOTTOM OF FORMATIONS

Sand and Shale	330'
Shale and Shells	689'
Anhydrite	702'
Shale and Shells	1,336'
Shale, Shells and Lime	1,821'
Shale and Lime	2,058'
Lime and Shale	3,739'
Lime	3,820'
Lime and Shale	4,024'
Lime	4,048'
Lime and Shale	4,220'
Rotary Total Depth	4,220'

I hereby certify the above and foregoing to be a true and correct log of the above described well as shown by the drilling reports.

H-30, Inc.

RECEIVED
STATE OF KANSAS
JUN 26 1978

Dean Britting
Dean Britting

State of Kansas } 6-26-78
County of Sedgwick } ss:

Subscribed and Sworn to before me a Notary Public in and for said county and state this 23rd day of June, 1978.

WILL, SO
NOTARY
KANSAS

Elsie Willison
Elsie Willison - Notary Public

My Commission Expires:
June 30, 1978