

WELL PLUGGING RECORD

OR

FORMATION PLUGGING RECORD


Strike out upper line when reporting plugging of formations.

STATE OF KANSAS
STATE CORPORATION COMMISSION

Give All Information Completely
Make Required Affidavit
Mail or Deliver Report to:

Conservation Division
State Corporation Commission
800 Bittling Building
Wichita, Kansas

NORTH

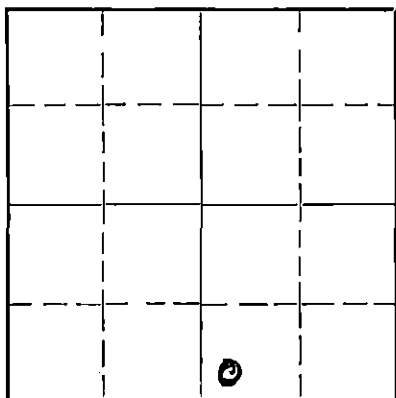

Locate well correctly on above Section Plat

Stafford County. Sec. ^{SW SW SE} 25 Twp. 25 Rge. 12 (W)
Location as NE 1/4 NW 1/4 SW 1/4 or footage from lines 330 feet from W line 330 A line
Lease Owner The National Refining Co
Lease Name Bonham
Office Address 304 Kaufman Bldg Wichita Kansas
Character of Well (Completed as Oil, Gas or Dry Hole) Oil
Date, well completed April 1 1938
Application for plugging filed 193
Application for plugging approved 193
Plugging Commenced June 12 1938
Plugging Completed June 17 1938
Reason for abandonment of well or producing formation drapability to get a pipeline in to take the oil
If a producing well is abandoned, date of last production May 31 1938
Was permission obtained from the Conservation Division or its agents before plugging was commenced? yes

Name of Conservation Agent who supervised plugging of this well Guy Ellersberry
Producing formation Arbuckle Dolomite Depth to top 4210 Bottom 4212 Total Depth of Well 4212 Feet.
Show depth and thickness of all water, oil and gas formations.

OIL, GAS OR WATER RECORDS

CASING RECORD


Formation	Content	From	To	Size	Put In	Pulled Out
				12 1/2	312'	00
				8 5/8 O.D.	3605'	1853'-1"
				7" O.D.	4209	3187'-5"

Describe in detail the manner in which the well was plugged, indicating where the cement was placed and the method or methods used in introducing it into the hole. If cement or other plugs were used, state the character of same and depth placed, from feet to feet for each plug set.

Bottom of Hole was filled with Cement from 4212 to 4187 and hole filled with heavy mud from 4187 to near the Bottom of 12 1/2 of about 380' where fresh water plug was set at 380' and a 15 foot cement branch. 10 feet of cement was run at top of pipe and Bottom of cellar.

2-3-39

PLUGGING
FILE SEC 25 TWP 25 RGE 12 W
BOOK PAGE 47 LINE 31

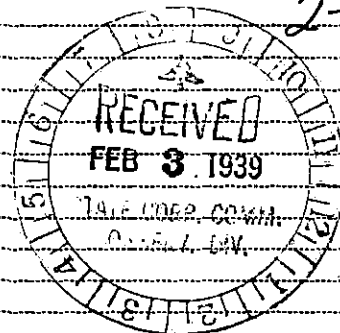

(If additional description is necessary, use BACK of this sheet)

Correspondence regarding this well should be addressed to The National Refining Co
Address 304 Kaufman Bldg Wichita Kansas

STATE OF Kansas COUNTY OF Sedgwick, ss.

O.W. Gornell (employee of owner) or (owner or operator) of the above-described well, being first duly sworn on oath, says: That I have knowledge of the facts, statements, and matters herein contained and the log of the above-described well as filed and that the same are true and correct. So help me God.

(Signature) O.W. Gornell
Russell Kansas Box 583
(Address)

SUBSCRIBED AND SWORN TO before me this 2nd day of February, 1939.

My commission expires May 5, 1941
Ruth Whove
Notary Public.

15-185-01344-0000


THE NATIONAL REFINING CO.

SW corner Se
T.D. 4212

#1 Bonham
28-25-12W

Stafford County

Commenced: 1-28-38
Completed: 4-2-38

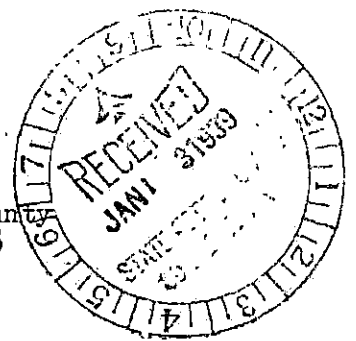

1-13-39

CASING RECORD

Rotary 0-3605
8 1/2" -3605
6 5/8" -4202

FORMATION	DEPTH	FORMATION	DEPTH
sand & gravel	390	cherty lime	4085
red shale	710	dark grey & green shale	4095
anhydrite	780	white, fine sandy lime	4116
red shale	1060	green & grey sandy shale	4145
shale	1250	green shale	4155
anhydrite & shale	1300	sand	4172
shale, gypsum, & anhydrite	1550	dark green shale	4190
anhydrite, shale & salt	1600	dark green pyritic shale	4200
anhydrite	1640	dolomitic lime	4209
shale	1670	dolomite	4212 T.D.
anhydrite & shale	1820		
lime & shale	1840		
dark cherty lime	1870	small show of oil	3430-40
cherty lime	1930	small show of oil	3680
dark cherty lime	1960	HFW	4075
shale & lime	2110	HFW	4165
cherty lime	2130	show oil	4208
shale & lime	2210	oil pay	4209-12
shaley lime	2235		
lime	2260	1000 acid	
oolitic, cherty lime	2280		
shale & lime	2370		
cherty lime	2390		
lime, shale & little red rock	2650		
lime	2710		
red & green shale	2720		
sandy lime	2740		
red & green shale	2790		
lime & little shale	2960		
red & green shale	2980		
lime	3080		
shale & little sand	3095		
lime	3520		
sand & sandy shale	3560		
shale	3566		
lime	3571		
grey shale	3580		
red shale	3582		
green shale	3585		
lime	3850		
lime & shale	3880		
lime	3900		
grey, green & red shale	3920		
cherty lime	3944		
shale & lime shells	3956		
grey, green & maroon detrital shale	3978		

PLUGGING
FILE SEC 28 25 12W
BOOK PAGE 49 LINE 34