


STATE OF KANSAS
STATE CORPORATION COMMISSION

Give All Information Completely
Make Required Affidavit
Mail or Deliver Report to:
Conservation Division
State Corporation Commission
800 Bitting Building
Wichita, Kansas

R 12 W NORTH

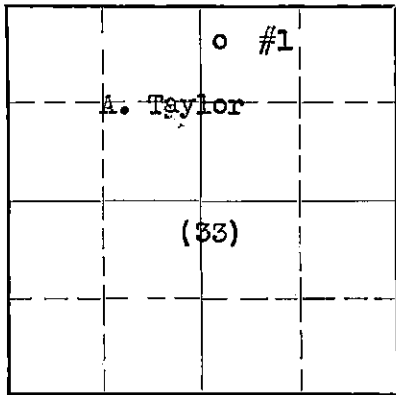

Locate well correctly on above
Section Plat

15-185-10123769000
WELL PLUGGING RECORD 10126

FORMATION PLUGGING RECORD

Strike out upper line
when reporting plug-
ging off formations.

7-12-38

Stafford County, Sec. 33, Twp. 25, Rge. (E) 12 (W)
Location as "NE $\frac{1}{4}$ NW $\frac{1}{4}$ SW $\frac{1}{4}$ " or footage from lines NW-NW-NE
Lease Owner Stanolind Oil and Gas Co.
Lease Name A. Taylor Well No. 1
Office Address Box 591, Tulsa Oklahoma
Character of Well (Completed as Oil, Gas or Dry Hole) Dry Hole
Date, well completed July 5 1938
Application for plugging filed July 5 (verbal) 1938
Application for plugging approved July 5 (verbal) 1938
Plugging Commenced July 6 1938
Plugging Completed July 6 1938
Reason for abandonment of well or producing formation Non-producing
If a producing well is abandoned, date of last production 1938
Was permission obtained from the Conservation Division or its agents before plugging was commenced? Yes

Name of Conservation Agent who supervised plugging of this well Ed. Scheil
Producing formation Siliceous Depth to top 4207 Bottom 4275 Total Depth of Well 4275 Feet.
Show depth and thickness of all water, oil and gas formations.

OIL, GAS OR WATER RECORDS


CASING RECORD

Formation	Content	From	To	Size	Put In	Pulled Out
Anhydrite	dry	675		10-3/4"	251'9" (Thds. Off)	None
Lansing	dry	3616				
Kinderhook	dry	4040				
Viola	dry	4060				
Simpson	dry	4125				
Siliceous	dry	4207				

Describe in detail the manner in which the well was plugged, indicating where the mud fluid was placed and the method or methods used in introducing it into the hole. If cement or other plugs were used, state the character of same and depth placed, from _____ feet to _____ feet for each plug set.

4275'-251' Heavy mud
251'-221' Cement
221'- 41' Heavy mud
41'-Cellar-Cement.

A steel cap was welded on surface casing in cellar.

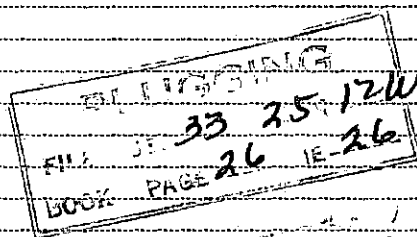

(If additional description is necessary, use BACK of this sheet)

Correspondence regarding this well should be addressed to Stanolind Oil and Gas Co
Address Box 591, Tulsa, Okla.

STATE OF Kansas, COUNTY OF Barton, ss.
H. G. Nething (employee of owner) or (owner or operator) of the above-described well,

being first duly sworn on oath, says: That I have knowledge of the facts, statements, and matters herein contained and the log of the above-described well as filed and that the same are true and correct. So help me God.

(Signature) *H. G. Nething*
Ellinwood, Kansas
(Address)

SUBSCRIBED AND SWORN TO before me this 9th day of July, 1938

Fran L. Wilcox
Notary Public.

My commission expires May 3, 1941