


WELL PLUGGING RECORD

Give All Information Completely
Make Required Affidavit
Mail or Deliver Report to:
Conservation Division
State Corporation Commission
211 No. Broadway
Wichita, Kansas

Stafford County, Sec. 33 Twp. 25S Rge. (EX 12(W))

NORTH

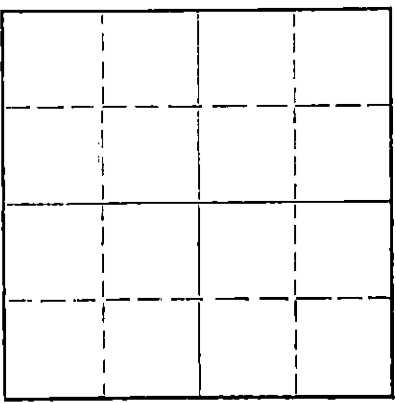

Locate well correctly on above Section Plat

Location as "NE/CNW/SW" or footage from lines NE NE SW
Lease Owner Navajo Drilling Co. & Clinton Oil Co.
Lease Name Green Well No. 1
Office Address 205 Central Bldg., Wichita, Kansas
Character of Well (completed as Oil, Gas or Dry Hole) Dry Hole
Date well completed Oct. 4 19 63
Application for plugging filed Oct. 4 19 63
Application for plugging approved Oct. 4 19 63
Plugging commenced Oct. 4 19 63
Plugging completed Oct. 4 19 63
Reason for abandonment of well or producing formation Dry Hole

If a producing well is abandoned, date of last production 19
Was permission obtained from the Conservation Division or its agents before plugging was commenced? Yes

Name of Conservation Agent who supervised plugging of this well Archie V. Elving, Pratt Kansas
Producing formation _____ Depth to top _____ Bottom _____ Total Depth of Well 4265 Feet
Show depth and thickness of all water, oil and gas formations.

OIL, GAS OR WATER RECORDS CASING RECORD

FORMATION	CONTENT	FROM	TO	SIZE	PUT IN	PULLED OUT
			221'	8-5/8"		

Describe in detail the manner in which the well was plugged, indicating where the mud fluid was placed and the method or methods used in introducing it into the hole. If cement or other plugs were used, state the character of same and depth placed, from _____ feet to _____ feet for each plug set.

RECEIVED
STATE CORPORATION COMMISSION

OCT-11-1963

CONSERVATION DIVISION
Wichita, Kansas

10-11-63

(If additional description is necessary, use BACK of this sheet)

Name of Plugging Contractor Navajo Drilling Co.
Address 205 Central Bldg., Wichita, Kansas

STATE OF Kansas, COUNTY OF Sedgwick, ss.
George R. Jones (owner or operator) of the above-described

well, being first duly sworn on oath, says: That I have knowledge of the facts, statements, and matters herein contained and the log of the above-described well as filed and that the same are true and correct. So help me God.

(Signature) George R. Jones

205 Central Bldg., Wichita, Kansas
(Address)

SUBSCRIBED AND SWORN to before me this 9th day of October, 19 63

My commission expires February 1, 1964
Barbara J. Layton
Barbara J. Layton Notary Public.



DRILLERS' LOG

Company: Navajo Oil Co. & Clinton Oil Co.
 Contractor: Navajo Oil Co.
 Farm: #1 Green, NE NE SW
 Sec. 33-25S-12W
 Stafford Co., Kansas
 Commenced: 9/25/63
 Completed: 10/4/63
 Casing: 8-5/8" @221' w/200 sx.

0	-	222	Red bed & shale
222	-	695	Red bed, shell & shales
695	-	720	Anhydrite
720	-	1535	Red bed & shale
1535	-	1695	Salt & shale
1695	-	1875	Shale & lime
1875	-	2035	Lime
2035	-	2235	Lime
2235	-	2440	Shale & lime
2440	-	2710	Shale & lime
2710	-	2885	Lime & shale
2885	-	3101	Shale
3101	-	3132	Lime
3132	-	3223	Lime
3223	-	3424	Lime w/shale
3424	-	3431	Lime
3431	-	3436	Heebner
3436	-	3569	Lime & shale
3569	-	3598	Shale & lime
3598	-	3623	Brown Lime
3623	-	3630	Lime-K. C.
3630	-	3706	Lime-K. C.
3706	-	3780	Lime
3780	-	3809	Lime
3809	-	3833	K. C. Lime
3833	-	3854	Lime
3854	-	3862	Lime
3862	-	3950	Lime, shale
3950	-	3978	Lime & shale
3978	-	4008	Conglomerate
4008	-	4045	Lime & shale
4045	-	4072	Mississippi
4072	-	4078	Shale & lime
4078	-	4118	Viola
4118	-	4153	Chert, lime
4153	-	4188	Simpson
4188	-	4223	Sandy Dolomite
4223	-	4265	Simp. & Arbuckle
		4265	Rotary Total Depth

RECEIVED
 STATE CORPORATION COMMISSION

OCT 11 1963

CONSERVATION DIVISION
 Wichita, Kansas

10-11-63

DRILLERS' LOG
Page -2-
#1 Green

I, George R. Jones, do hereby certify that the above and foregoing is a true and correct copy of the log of the #1 Green, NE NE SW, Sec. 33-25S-12W, Stafford County, Kansas, as reflected by the files of Navajo Drilling Co.

George R. Jones
GEORGE R. JONES

State of Kansas)
) ss:
County of Sedgwick)

Subscribed and sworn to before me, a Notary Public in and for Sedgwick County, Kansas this 9th day of October, 1963.

My Commission Expires:
February 1, 1964

Barbara J. Layton
Barbara J. Layton, Notary Public

RECEIVED
STATE CORPORATION COMMISSION

OCT 11 1963

CONSERVATION DIVISION
Wichita, Kansas

10-11-63