


Give All Information Completely
Make Required Affidavit
Mail or Deliver Report to:
Conservation Division
State Corporation Commission
800 Bittling Building
Wichita, Kansas

15-185-00174-0000
WELL PLUGGING RECORD

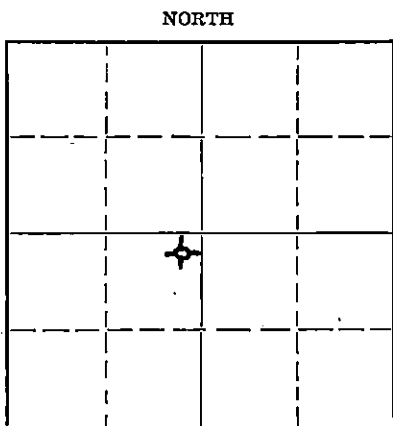

Locate well correctly on above
Section Plat

Stafford County, Sec. 31 Twp. 25S Rge. (E) 12(W)
Location as "NE/CNW $\frac{1}{4}$ SW $\frac{1}{4}$ " or footage from lines NE $\frac{1}{4}$ -NE $\frac{1}{4}$ -SW $\frac{1}{4}$
Lease Owner Champlin Refining Company
Lease Name Edith Shinkle Well No. 1
Office Address P.O. Dr. #552 Enid, Oklahoma
Character of Well (completed as Oil, Gas or Dry Hole) Dry hole
Date well completed December 28 19 52
Application for plugging filed December 27 19 52
Application for plugging approved December 27 (Verbal) 19 52
Plugging commenced December 28 19 52
Plugging completed December 28 19 52
Reason for abandonment of well or producing formation

If a producing well is abandoned, date of last production 19
Was permission obtained from the Conservation Division or its agents before plugging was commenced? Yes

Name of Conservation Agent who supervised plugging of this well Merle Rives, Pratt, Kansas
Producing formation Depth to top Bottom Total Depth of Well 4330 Feet
Show depth and thickness of all water, oil and gas formations.

OIL, GAS OR WATER RECORDS

CASING RECORD

Formation	Content	From	To	Size	Put In	Pulled Out
				13 3/8"	278'	None
				8 5/8"	1731'	None

Describe in detail the manner in which the well was plugged, indicating where the mud fluid was placed and the method or methods used in introducing it into the hole. If cement or other plugs were used, state the character of same and depth placed, from feet to feet for each plug set.

Filled hole with heavy rotary mud from 4330' T.D. to 300' and rolled up 6" diameter of hulls in sack and pushed down to 300' then set Halliburton plug at 300' and pumped in 35 sacks cement. Then filled hole with Heavy rotary mud from top of plug T. 40' and set Halliburton plug at 40' and filled hole with cement from top of plug to bottom of celler using 15 sacks cement.

RECEIVED
STATE CORPORATION COMMISSION

DEC 31 1952

12-31-52

CONSERVATION DIVISION
Wichita, Kansas

(If additional description is necessary, use BACK of this sheet)

Name of Plugging Contractor Champlin Refining Company (Company tools)
Address P.O. Dr. #552 Enid, Oklahoma

STATE OF Kansas, COUNTY OF Barton, ss.
S. P. Hall (employee of owner) or (owner or operator)

being first duly sworn on oath, says: That I have knowledge of the facts, statements, and matters herein contained and the log of the above-described well as filed and that the same are true and correct. So help me God.

(Signature)

Box 167, Ellinwood, Kansas

(Address)

SUBSCRIBED AND SWORN TO before me this 29th day of December, 1952

My commission expires September 10, 1955

23-8390-s

6-51-20M


PLUGGING

SEC 31 T 25 R 12

BOOK PAGE 69 LINE 28

15-185-00174-0000

(For use in connection only; for re-printing or other record)

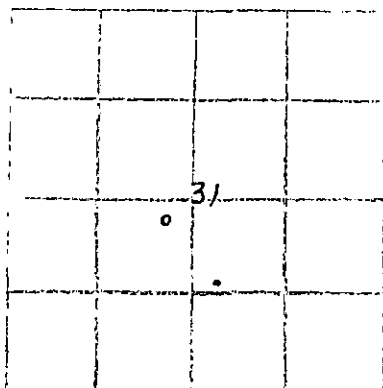

S

COUNTY Stafford SEC. 31 TWP. 25S RGE. 12W
 COMPANY OPERATING Champlin Refining Company
 OFFICE ADDRESS Box 552 - Enid, Oklahoma
 WELLS NAME Shinkle WELL NO. 1
 WELL LOCATED NE/4 NE/4 SW/4 or 2310' from West Line and
2310' from South Line of SW/4
 CHARACTER OF WELL Dry Hole

DRILLING COMMENCED December 7, 1952

DRILLING COMPLETED December 28, 1952

SIZE	WEIGHT	THDS	MAKE	FT.	INS.	AMOUNT PULLED	CONTENT
13-3/8"	48#	8 Rd	National	280'			250 Sacks
8-5/8"	28#	8 Rd	National	1725.41'			400 Sacks

FORMATION RECORD

	TOPS	BOTTOM
Sand-Gravel	0	70
Sand	70	282
Sand-Redbed	282	755
Shale-Anhydrite	755	1175
Shale-Sand	1175	1500
Shale-Anhydrite-Salt	1500	1707
Shale-Anhydrite	1707	1785
Shale-Lime	1785	3156
Lime	3156	3265
Shale-Lime	3265	3405
Lime	3405	3472
Lime-Sand	3472	3530
Shale-Lime-Sand	3530	3600
Shale-Lime	3600	3682
Lime	3682	3967
Shale-Lime-Chert	3967	3990
Shale-Lime	3990	4048
Cherty Lime	4048	4140
Chert-Lime	4140	4187
Shale-Lime	4187	4210
Shale-Sand	4210	4238
Shale	4238	4240
Lime	4240	4330 T.D.

Elevation: 1891 K.B.

Geological Tops:

TOPS	BOTTOM
Heebner	3460
Lansing	3650
Base K.C.	3946
Mississippi	4062
Viola	4118
Simpson Shale	4194
Sand	4196
Arbuckle	4276

PLUGGING

SEC 31 TWP 25S RGE 12W
 PAGE 69 LINE 28

Subscribed and sworn to before me
 this 8 day of January, 1953

Don Thier

Notary Public

Thurmond Worth
 SUPERVISOR OF MINES
 STATE OF OKLAHOMA

MAILED - 1953 1-9-53

RECORDATION DIVISION
 By J. J. Harrison, Registrar August 14, 1954