

FOR KCC USE:

FORM C-1 7/91

EFFECTIVE DATE

7-2-93

State of Kansas

FORM MUST BE TYPED

DISTRICT# 2

NOTICE OF INTENTION TO DRILL

FORM MUST BE SIGNED

SGA? Yes...No

Must be approved by the K.C.C. five (5) days prior to commencing well

ALL BLANKS MUST BE FILLED

EXPECTED SPUD DATE: 07 01 93 month day year

Spot NW SW NW Sec 14 Twp 24 S, Rg 09 WW EAST WEST

Operator: License#: 04661 Name: GALLOWAY PETROLEUM EXPLR., INC Address: 360 BROADWAY PLAZA BLDG. City/State/Zip: WICHITA KS. 67202 Contact Person: CASEY GALLOWAY Phone: 316-267-7355

3630 feet from (South) / Line of Section 4950 feet from (East) / Line of Section IS SECTION XX REGULAR IRREGULAR?

NOTE: Locate well on the Section Plat on Reverse Side)

COUNTY: RENO

LEASE NAME: MEDSKER "A" WELL#: 1-14

Field Name: LANGDON

Is this a Prorated/Spaced Field? yes XX no

Target Formation(s): MISSISSIPPI

Nearest lease or unit boundary: 330

Ground Surface Elevation: APX 1670 feet MSL

Water well within one-quarter mile: yes XX no

Public water supply well within one mile: yes XX no

Depth to bottom of fresh water: 80

Depth to bottom of usable water: 130

Surface Pipe by Alternate: XX 1 2

Length of Surface Pipe Planned to be set: 150

Length of Conductor Pipe required: NONE

Projected Total Depth: 4000

Formation at Total Depth: KINDERHOOK

Water Source for Drilling Operations: well farm pond XX Other

DWR Permit#

Will Cores Be Taken? yes XX no

If yes, proposed zone:

CONTRACTOR: License #

Name: WILL ADVISE ON ACO-1

316-278-3392

Well Drilled For: Well Class: Type Equipment:

XX Oil Enh Rec Infield XX Mud Rotary XX Gas Storage XX Pool Ext. Air Rotary OWWO Disposal Wildcat Cable Seismic; # of Holes Other

If OWWO: old well information as follows:

Operator:

Well Name:

Comp. Date: Old Total Depth

Directional, Deviated or Horizontal wellbore? yes XX no

If yes, true vertical depth:

Bottom Hole Location

AFFIDAVIT

The undersigned hereby affirms that the drilling, completion and eventual plugging of this well will comply with K.S.A. 65-101 et. seq.

It is agreed that the following minimum requirements will be met:

- 1. Notify the appropriate district office prior to spudding of well. 2. A copy of the approved notice of intent to drill shall be posted on each drilling rig: 3. The minimum amount of surface pipe as specified below shall be set by circulating cement to the top: in all cases surface pipe shall be set through all unconsolidated materials plus a minimum of 20 feet into the underlying formation 4. If the well is dry hole, an agreement between the operator and district office on plug length and placement is necessary prior to plugging: 5. The appropriate district office will be notified before well is either plugged or production casing is cemented in: 6. IF AN ALTERNATE II COMPLETION, PRODUCTION PIPE SHALL BE CEMENTED FROM BELOW ANY USABLE WATER TO SURFACE WITHIN (120) DAYS OF SPUD DATE. IN ALL CASES, NOTIFY DISTRICT OFFICE PRIOR TO ANY CEMENTING.

I hereby certify that the statements made herein are true and to the best of my knowledge and belief.

Date: 06/11/93 Signature of Operator or Agent: Title: PRESIDENT

856

RECEIVED KANSAS CORPORATION COMMISSION

JUN 11 1993 6-11-93 CONSERVATION DIVISION WICHITA, KS

FOR KCC USE: API # 15- 155-21267-0000 Conductor Pipe required None feet Minimum surface pipe required 150 feet per Alt. 0 X Approved by: C.B. 6-25-93 This Authorization expires: 12-25-93 (This authorization void if drilling not started within 6 months of effective date.) Spud date: Agent:

REMEMBER TO:

- File Drill Pit Application (form CDP-1) with intent to Drill; File Completion Form ACO-1 within 120 days of spud date; File acreage attribution plat according to field proration orders; Notify appropriate district office 48 hour prior to workover or re-entry; Submit plugging report (CP-4) after plugging is completed; Obtain written approval before disposing or injecting salt water.

Mail to: Conservation Division, 200 Colorado Derby Building, 202 W. First St., Wichita, Kansas 67202-1286.

14 255 9w

IN ALL CASES PLOT THE INTENDED WELL ON THE PLAT BELOW

PLAT OF ACREAGE ATTRIBUTABLE TO A WELL IN A PRORATED OR SPACED FIELD

If the intended well is in a prorated or spaced field, please fully complete this side of the form. If the intended well is in a prorated or spaced field complete the plat below showing that the well will be properly located in relationship to other wells producing from the common source of supply. Please show all the wells within 1 mile of the boundaries of the proposed acreage attribution unit for gas wells and within 1/2 mile of the boundaries of the proposed acreage attribution unit for oil wells.

API NO. 15- _____
 OPERATOR _____
 LEASE _____
 WELL NUMBER _____
 FIELD _____



LOCATION OF WELL: COUNTY _____
 _____ feet from (South) / North Line of Section
 _____ feet from (East) / West line of section
 SECTION _____ TWP _____ RG _____

ACRES ATTRIBUTABLE TO WELL _____
 QTR/QTR/QTR OF ACREAGE _____

IS SECTION XX REGULAR or _____ IRREGULAR
IF SECTION IS IRREGULAR, LOCATE WELL FROM NEAREST CORNER BOUNDARY
 Section corner used: _____ NE _____ NW _____ SE _____ SW

PLAT

(Show location of the well and shade attributable acreage for prorated or spaced wells.)
 (Show footage to the nearest lease or unit boundary line.)

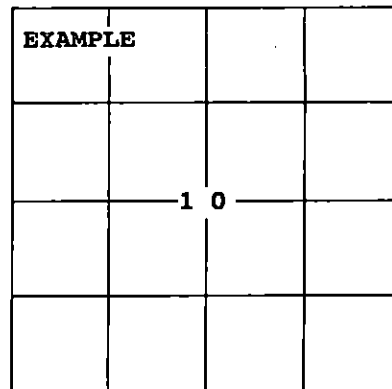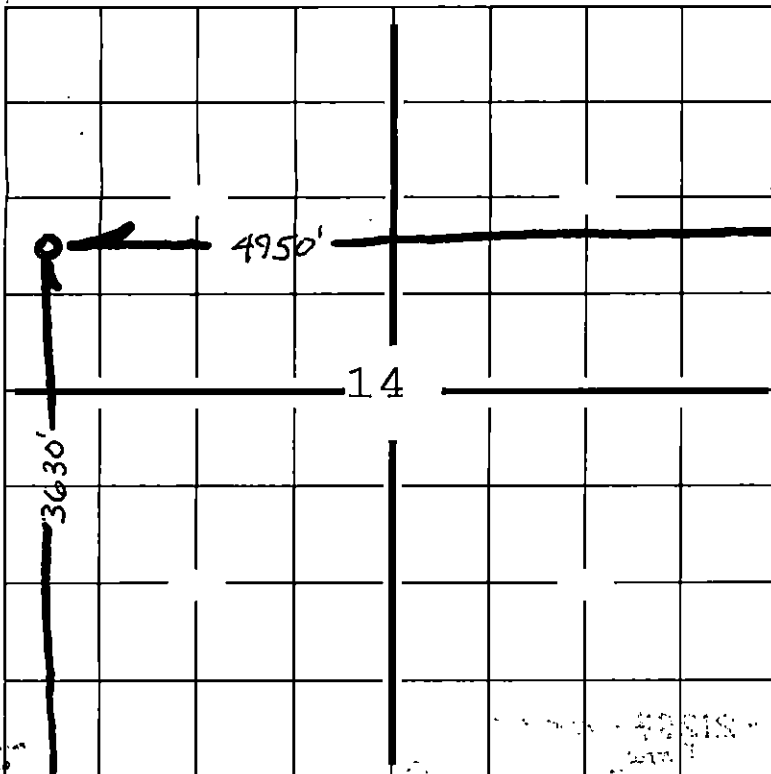

SEWARD CO.

In plotting the proposed location of the well, you must show:

- 1) The manner in which you are using the depicted plat by identifying section lines, i.e. 1 section, 1 section with 8 surrounding sections, 4 sections, etc.;
- 2) the distance of the proposed drilling location from the section's south/north and east/west lines; and
- 3) the distance to the nearest lease or unit boundary line.