


STATE OF KANSAS
STATE CORPORATION COMMISSION

WELL PLUGGING RECORD

Give All Information Completely
Make Required Affidavit
Mail or Deliver Report to
Conservation Division
State Corporation Comm.
245 North Water
Wichita, KS 67202

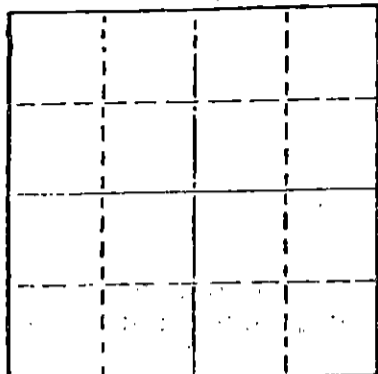

Locate well correctly on above Section Plat

Stafford County, Sec. 17 Twp. 25S Rge. 12W XXX
Location as "NE/CNW $\frac{1}{4}$ SW $\frac{1}{4}$ " or footage from lines
150' N NW NE NW

Lease Owner Duke Drilling Company
Lease Name Bleger Well No. 1
Office Address Box 823, Great Bend, Kansas 67530
Character of Well (Completed as Oil, Gas or Dry Hole) _____

Dry Hole

Date Well completed November 14, 1976
Application for plugging filed Verbal Application 19____
Application for plugging approved Verbal Approval 19____
Plugging commenced November 14, 1976
Plugging completed November 14, 1976
Reason for abandonment of well or producing formation _____

If a producing well is abandoned, date of last production _____ 19____

Was permission obtained from the Conservation Division or its agents before plugging was commenced? Yes

Name of Conservation Agent who supervised plugging of this well G. R. Biberstein
Producing formation _____ Depth to top _____ Bottom _____ Total Depth of Well 4020'
Show depth and thickness of all water, oil and gas formations.

OIL, GAS OR WATER RECORDS

CASING RECORD

DATE	FORMATION	CONTENT	FROM	TO	SIZE	PUT IN	PULLED OUT
NOV 10 1976					8-5/8"	309'	None

Describe in detail the manner in which the well was plugged, indicating where the mud fluid was placed and the method or methods used in introducing it into the hold. If cement or other plugs were used, state the character of same and depth placed, from _____ feet to _____ feet for each plug set.

Filled hole with heavy rotary mud from 4,020 ft. (rotary total depth) to 300 ft. Set plug at 300 ft. and cemented with 35 sacks cement.
Filled hole with heavy rotary mud from 300 ft. to 40 ft.
Set solid plug at 40 ft. and cemented to cellar with 15 sacks cement, 5 sacks cement in rat hole.

Plugging operations accomplished utilizing Halliburton Oil Well cementing pump truck through 4-1/2 inch drill pipe.

(If additional description is necessary, use BACK of this sheet)

Name of Plugging Contractor Halliburton Services
410 Union Center Building, Wichita, Kansas 67202

STATE OF Kansas COUNTY OF Sedgwick
Merle Britting, Agent (employee of owner) or (owner or operator) of the above-described well, being first duly sworn on oath, says: That I have knowledge of the facts, statements, and matters herein contained and the log of the above-described well as filed and that the same are true and correct. So help me God.

(Signature) Merle Britting
200 No. Main, Wichita, Kansas 67202
(Address)

SUBSCRIBED AND SWORN TO before me this 17th day of November, 19 76

My commission expires June 30, 1978

Elsie Willison
Notary Public


COMPANY Duke Drilling Company

SEC. 17 T. 25S R. 12W
 LOC. NW NE NW

FARM Bleger NO. 1

TOTAL DEPTH 4,020'
 COMM. November 4, 1976 COMP. November 14, 1976
 SHOT OR TREATED
 CONTRACTOR H-30, Inc.
 ISSUED November 17, 1976

COUNTY Stafford
 KANSAS

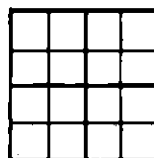

CASING

20	10		
15	5	5/8" 309' cemented w/250 sxs cement	ELEVATION 1898 KB
12	6		
13	5		

PRODUCTION

FIGURES INDICATE BOTTOM OF FORMATIONS

Sand	135'
Shale	310'
Shale and Red Bed	395'
Red Bed	623'
Anhydrite	643'
Shale	727'
Shale and Red Bed	1,110'
Red Bed and Shale	1,725'
Lime and Shale	1,820'
Shale and Lime	2,025'
Lime and Shale	3,650'
Lime	3,810'
Lime and Shale	3,895'
Lime	4,020'
Rotary Total Depth	4,020'

RECEIVED
 THE CORPORATION

I hereby certify the above and foregoing
 to be a true and correct log of the above
 described well as shown by the drilling
 reports.

H-30, INC.

Merle Britting
 Merle Britting

State of Kansas }
 County of Sedgwick } ss:

Subscribed and Sworn to before me a Notary
 Public in and for said county and state
 this 17th. day of November, 1976.

Elsie Willison
 Elsie Willison - Notary Public

My Commission Expires:

June 30, 1978

