


STATE OF KANSAS  
STATE CORPORATION COMMISSION

Give All Information Completely  
Make Required Affidavit  
Mail or Deliver Report to:  
Conservation Division  
State Corporation Commission  
212 No. Market  
Wichita, Kansas

WELL PLUGGING RECORD

Stafford County. Sec. 1 Twp. 25 Rge. (E) 15 (W)  
Location as "NE/CNW/SW" or footage from lines SW NW SW  
Lease Owner McAdams Pipe & Supply Company  
Lease Name Reese Well No. 2  
Office Address Drawer 960, Bristow, Oklahoma  
Character of Well (completed as Oil, Gas or Dry Hole) oil  
Date well completed \_\_\_\_\_ 19\_\_\_\_  
Application for plugging filed January 8 19 68  
Application for plugging approved \_\_\_\_\_ 19\_\_\_\_  
Plugging commenced January 22 19 68  
Plugging completed January 27 19 68  
Reason for abandonment of well or producing formation depleted

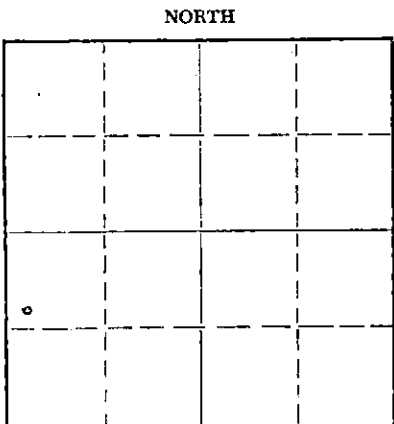

Locate well correctly on above Section Flat

If a producing well is abandoned, date of last production \_\_\_\_\_ 19\_\_\_\_  
Was permission obtained from the Conservation Division or its agents before plugging was commenced? yes

Name of Conservation Agent who supervised plugging of this well Archie Elving  
Producing formation \_\_\_\_\_ Depth to top \_\_\_\_\_ Bottom \_\_\_\_\_ Total Depth of Well 4439 Feet  
Show depth and thickness of all water, oil and gas formations.

OIL, GAS OR WATER RECORDS

CASING RECORD

FORMATION	CONTENT	FROM	TO	SIZE	PUT IN	PULLED OUT
		0	272'	8 5/8"	272'	none
		0	4436'	5 1/2"	4436'	3174.76

Describe in detail the manner in which the well was plugged, indicating where the mud fluid was placed and the method or methods used in introducing it into the hole. If cement or other plugs were used, state the character of same and depth placed, from \_\_\_\_\_ feet to \_\_\_\_\_ feet for each plug set.

Sand back from 4439' to 4400'. Mixed and dumped 5 sacks of cement on sand.  
Pushed plug to 260', set 10' rock bridge and dumped 25 sacks of cement.  
Filled hole with mud to 40', set 10' rock bridge and capped hole with 10 sacks of cement.

RECEIVED  
STATE CORPORATION COMMISSION  
FEB 13 1968  
CONSERVATION DIVISION  
Wichita, Kansas

(If additional description is necessary, use BACK of this sheet)  
Name of Plugging Contractor Pipe Pullers, Inc.  
Address Box 486, Ellinwood, Kansas

STATE OF Kansas, COUNTY OF Barton, ss.  
Ed Schonhoff (employee of owner) or (owner or operator) of the above-described

well, being first duly sworn on oath, says: That I have knowledge of the facts, statements, and matters herein contained and the log of the above-described well as filed and that the same are true and correct. So help me God.

(Signature) E. S. Schonhoff  
Ellinwood, Kansas (Address)

SUBSCRIBED AND SWORN TO before me this 30 day of January, 1968

My commission expires July 7, 1968 Notary Public.

INTENTION & FAITH - Operator

SIERRA PETROLEUM CO., INC - Contractor

Block #2  
 SW 1/4 SW  
 Sec. 1-29-13W  
 Stafford County, Kansas

T. D.: 4291  
 Elev.: 2019' K.S.

Commenced: 10-17-60  
 Completed: 1-1-61

Coatings:	Count:	DEPTH
3-1/2" Set @ 272'	with 210 cc. cement	
1-1/2" Set @ 4291'	with 200 cc. cement	
FORMATION		DEPTH
Sand		40
Sand & Gravel		160
Shale & Shells		272
Shale & Red Bed		310
Sand		429
Red Bed & Shale		929
Anhydrite		980
Shale & Shells		1200
Salt		1305
Shale & Shells		1720
Shale & Lime		2120
Lime		2663
Lime & Shale		2797
Lime		3099
Shale & Lime		4293
Mississippi		4263
Lime		4409
<b>7075:</b>		
Anhydrite		925
Wichita		1008
Taronto		1026
Douglas		1026
Brown Lime		1732
Lans, K. C.		2711
Essex K. C.		4040
Mississippi		4191
Windsorhook		4261
Viola		4399
Arbuckle		4438

RECEIVED  
 STATE CORPORATION COMMISSION  
 JAN - 9 1968  
 CONSERVATION DIVISION  
 Wichita, Kansas

STATE OF KANSAS }  
 COUNTY OF RICE } ss:

I hereby certify that the above information is true and correct to the best of my knowledge.

C. P. Heniker

Subscribed & sworn to before me this 3rd day of January

John Lee  
 Notary Public

My commission expires: 10-17-69