

STATE OF KANSAS
STATE CORPORATION COMMISSION

15-185-20830-0000

WELL PLUGGING RECORD

Give All Information Completely
Make Required Affidavit
Mail or Deliver Report to
Conservation Division
State Corporation Comm.
245 North Water
Wichita, KS 67202

Stafford County. Sec. 1 Twp. 25S Rge. 15W
Location as "NE/CNW $\frac{1}{4}$ SW $\frac{1}{4}$ " or footage from lines
C NW/4

Lease Owner Hummon Oil Company
Lease Name Waters Well No. 1
Office Address 1725 Vickers-KSB&T Bldg, Wichita, Ks.
Character of Well (Completed as Oil, Gas or Dry Hole)

Dry Hole


Date Well completed June 22, 1978
Application for plugging filed June 22, 1978
Application for plugging approved June 22, 1978
Plugging commenced June 22, 1978
Plugging completed June 22, 1978
Reason for abandonment of well or producing formation

Dry Hole

If a producing well is abandoned, date of last production
19

Was permission obtained from the Conservation Division or
its agents before plugging was commenced? Yes

Name of Conservation Agent who supervised plugging of this well
Producing formation _____ Depth to top _____ Bottom _____ Total Depth of Well 4225
Show depth and thickness of all water, oil and gas formations.

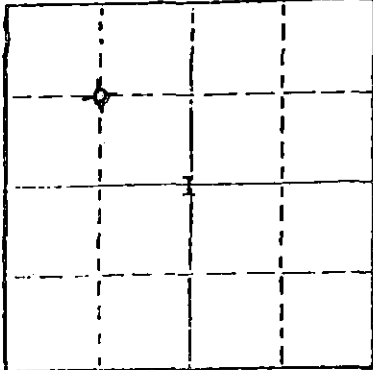

Locate well correctly on above
Section Plot

OIL, GAS OR WATER RECORDS

CASING RECORD

FORMATION	CONTENT	FROM	TO	SIZE	PUT IN	PULLED OUT
		0'	285'	8-5/8"	278.56'	None

Describe in detail the manner in which the well was plugged, indicating where the mud fluid
was placed and the method or methods used in introducing it into the hold. If cement or other
plugs were used, state the character of same and depth placed, from _____ feet to
_____ feet for each plug set.

Plugged with 40 sacks cement and plug at 540',
40 sacks cement at 240', 12 sacks cement at 40',
and 3 sacks cement in rat hole.

RECEIVED
STATE CORPORATION COMMISSION

JUL 12 1978

(If additional description is necessary, use BACK OF CONSERVATION DIVISION
Name of Plugging Contractor Allied Cementing Co. Wichita, Kansas

STATE OF KANSAS COUNTY OF SEDGWICK, ss.
John D. Knightley, Agent, (employee of owner) or (owner or operator)
of the above-described well, being first duly sworn on oath, says: That I have knowledge of
the facts, statements, and matters herein contained and the log of the above-described well
as filed and that the same are true and correct. So help me God.

(Signature) [Signature]
221 S. Broadway, Wichita, Kansas
(Address)

SUBSCRIBED AND SWORN TO before me this 11th day of July, 1978

[Signature]
Notary Public.

My commission expires March 12, 1979

15-185-26830-0000

Hummon Oil Company - Waters #1
C NW Sec. 1-25S-15W
Stafford County, Kansas

Contractor: D. R. Lauck Oil Company, Inc.
221 S. Broadway, Suite 400
Wichita, Kansas 67202

Commenced: June 8, 1978
Completed: June 22, 1978

Drillers Log

Shale	20
Sand	155
Shale	288
Red Bed	951
Anhydrite	968
Shale & Shells	1125
Shale	1940
Shale & Lime	3660
Lime	4225 RTD

RECEIVED
STATE CORPORATION COMMISSION

JUL 12 1978

CONSERVATION DIVISION
Wichita, Kansas