


STATE OF KANSAS
CORPORATION COMMISSION
Give All Information Completely
Make Required Affidavit
Mail or Deliver Report to:
Conservation Division
State Corporation Commission
212 No. Market
Wichita, Kansas

WELL PLUGGING RECORD

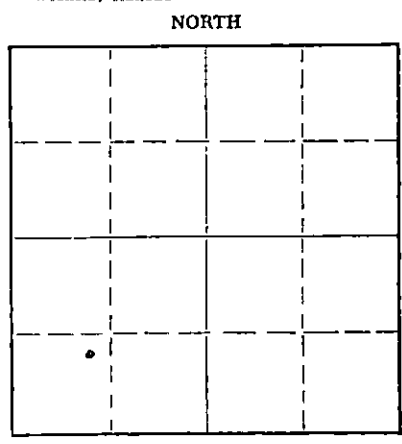

Stafford County. Sec. 1 Twp. 25 Rge. (E) 15(W)
Location as "NE/CNW/SW" or footage from lines. NE SW SW
Lease Owner McAdams Pipe & Supply Company
Lease Name Reese Well No. 3
Office Address Drawer 960, Bristow, Oklahoma
Character of Well (completed as Oil, Gas or Dry Hole) oil
Date well completed 19
Application for plugging filed January 8 1968
Application for plugging approved 19
Plugging commenced February 2 1968
Plugging completed February 8 1968
Reason for abandonment of well or producing formation depleted

If a producing well is abandoned, date of last production 19
Was permission obtained from the Conservation Division or its agents before plugging was commenced? yes

Name of Conservation Agent who supervised plugging of this well Archie Elving
Producing formation Depth to top Bottom Total Depth of Well 4434 Feet
Show depth and thickness of all water, oil and gas formations.

OIL, GAS OR WATER RECORDS

CASING RECORD

FORMATION	CONTENT	FROM	TO	SIZE	PUT IN	PULLED OUT
		0	276'	8 5/8"	276'	none
		0	4290'	5 1/2"	4290'	3360.01

Describe in detail the manner in which the well was plugged, indicating where the mud fluid was placed and the method or methods used in introducing it into the hole. If cement or other plugs were used, state the character of same and depth placed, from feet to feet for each plug set.

Sand back to 4200' and dumped 5 sacks of cement.
Pushed plug to 260'; set 10' rock bridge and dumped 6 sacks of cement.
Bailed hole down and dumped 19 sacks of cement. Filled hole with mud to 40', set 10' rock bridge and capped hole with 10 sacks of cement.

RECEIVED
STATE CORPORATION COMMISSION
FEB 13 1968
CONSERVATION DIVISION
Wichita, Kansas

(If additional description is necessary, use BACK of this sheet)
Name of Plugging Contractor Pipe Pullers, Inc.
Address Box 486, Ellinwood, Kansas

STATE OF Kansas, COUNTY OF Barton, ss.
Ed Schonhoff (employee of owner) or (owner or operator) of the above-described well, being first duly sworn on oath, says: That I have knowledge of the facts, statements, and matters herein contained and the log of the above-described well as filed and that the same are true and correct. So help me God.

(Signature) Ed Schonhoff
Ellinwood, Kansas (Address)

SUBSCRIBED AND SWORN to before me this 12th day of February, 1968

My commission expires July 7, 1968 Notary Public.

HELMTRICH & PAINE, INC. - Operator

SINRA PETRO. CO., INC. - Contr.

WFSW #9
NW SW SW
Sec. 1-25-154
Stafford County, Kansas

T. D. # 4134
Elev. # 2015' K.R.

Commenced: 11-7-61
Completed: 11-21-61

Coring:

8-5/8" Cor at 276'
5-1/2" Cor at 470'

Concret:

with 225 cc. cement
with 125 cc. cement

FORMATION

DEPTH

Sand
Shale
Red Ind
Anhydrite
Shale & Shells
Salt
Shale & Shells
Lime & Shale
Lime
Lime & Shale
Lime
Lime & Shale
Lime
Lime & Chert
Mississippi
Kinderhook
Viola
Simpson
Arbuckle

100
300
930
951
1245
1520
1810
2205
2310
3516
3619
3770
4125
4204
4210
4270
4353
4417
4431

RECEIVED
STATE CORPORATION COMMISSION
JAN - 9 1968
CONSERVATION DIVISION
Wichita, Kansas

TOPS:

Anhydrite
Kochner
Toronto
Douglas
Brown Lime
Lens. K. C.
Mississippi
Kinderhook
Viola
Simpson
Arbuckle

930
3616
3637
3656
3765
3777
4182
4226
4270
4362
4426

STATE OF KANSAS }
COUNTY OF RUSSELL } ss:

I hereby certify that the above information is true
and correct to the best of my knowledge.

C.T. Gonzalez

Subscribed and sworn to before me this 21st day of November,

1961.

Henry Dietz
Notary Public

My commission expires: 10-17-63