


STATE OF KANSAS
STATE CORPORATION COMMISSION

WELL PLUGGING RECORD

Give All Information Completely
Make Required Affidavit
Mail or Deliver Report to
Conservation Division
State Corporation Comm.
245 North Water
Wichita, KS 67202

Stafford County, Sec. 17 Twp. 25S Rge. 15 ~~XXW~~
Location as "NE/CNW $\frac{1}{4}$ SW $\frac{1}{4}$ " or footage from lines
330' FNL & 2780' FWL
Lease Owner Bill J. Dutton Oil Co.
Lease Name Wilson Well No. 1
Office Address 620 First National Center, Hutchinson
Character of Well (Completed as Oil, Gas or Dry Hole) Ks.
dry hole 67501

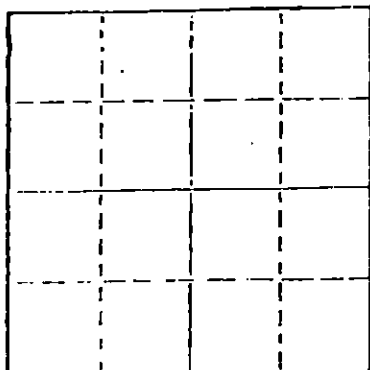

Locate well correctly on above
Section Plat

Date Well completed 10-14 1979
Application for plugging filed 10-14 1979
Application for plugging approved 10-14 1979
Plugging commenced 10-14 1979
Plugging completed 10-14 1979
Reason for abandonment of well or producing formation
no commercial quantities of oil or gas encountered
If a producing well is abandoned, date of last production
-- 19

Was permission obtained from the Conservation Division or
its agents before plugging was commenced? yes

Name of Conservation Agent who supervised plugging of this well Dwayne Rankin

Producing formation _____ Depth to top _____ Bottom _____ Total Depth of Well 4249

Show depth and thickness of all water, oil and gas formations.

OIL, GAS OR WATER RECORDS

CASING RECORD

| FORMATION | CONTENT | FROM | TO | SIZE | PUT IN | PULLED OUT |
|--------------|---------|------|-----|-------|--------|------------|
| surface hole | shale | surf | 329 | 8-5/8 | 321 | none |
| | | | | | | |
| | | | | | | |

Describe in detail the manner in which the well was plugged, indicating where the mud fluid was placed and the method or methods used in introducing it into the hold. If cement or other plugs were used, state the character of same and depth placed, from _____ feet to _____ feet for each plug set.

Fluid to 360', plug, 50 sx
Fluid to 40', plug, 10 sx
Rat hole 10 sx

10-23-79

RECEIVED
OCT 25 1979
DIVISION
Wichita, Kansas

(If additional description is necessary, use BACK of this sheet)

Name of Plugging Contractor D N B DRILLING, INC.
515 R. H. Garvey Building

Wichita, Kansas 67202

STATE OF Kansas COUNTY OF Sedgwick, ss.
Ella Priess (employee of owner) or (owner or operator)

of the above-described well, being first duly sworn on oath, says: That I have knowledge of the facts, statements, and matters herein contained and the log of the above-described well as filed and that the same are true and correct. So help me God.

(Signature)

Ella Priess

515 R.H. Garvey Bldg., Wichita, Ks. 67202
(Address)

SUBSCRIBED AND SWORN TO before me this 15th day of October, 19 79

Dorothy L. Schmidt
Dorothy L. Schmidt Notary Public.

My commission expires April 30, 1983

DOROTHY L. SCHMIDT
STATE NOTARY PUBLIC
Sedgwick County, Kansas
My Comm. Exp. April 30, 1983

15-185-20964-0000

DRILLER'S LOG

BILL J. DUTTON OIL CO.
No. 1 Wilson
330' FNL & 2790' FWL
Sec. 17-25S-15W
Stafford Co., Ks.

Commenced: 10-9-79
Completed: 10-14-79

Surface Casing: 321' of 8-5/8"
cemented w/320 sx common, 2% gel,
3% cc

| <u>FORMATION</u> | <u>DEPTH</u> |
|------------------|-----------------|
| Surface Hole | 0 - 329 |
| Shale | 329 - 985 |
| Anhydrite | 985 - 1006 |
| Shale | 1006 - 1740 |
| Lime & Shale | 1740 - 2005 |
| Shale & Lime | 2005 - 2520 |
| Lime & Shale | 2520 - 2835 |
| Lime | 2836 - 3105 |
| Lime & Shale | 3105 - 4025 |
| Lime | 4025 - 4249 RTD |

I do hereby certify that the foregoing statements are true and correct to the best of my knowledge and belief.

D. N. B. DRILLING, INC.

Ella Priess
Ella Priess

STATE OF KANSAS: ss:

Subscribed and sworn to before me this 16th day of October, 1979.

Dorothy L. Schmidt
Dorothy L. Schmidt, Notary Public

DOROTHY L. SCHMIDT
STATE NOTARY PUBLIC
Sedgwick County, Kansas
My Appt. Exp. April 30, 1983

RECEIVED
STATE DEPARTMENT OF COMMISSIONER

OCT 23 1979
10-23-79
CONCRETE DIVISION
Topeka, Kansas