

15-047-21052-0000

RECEIVED

STATE CORPORATION COMMISSION
Form CP-4
Rev. 12-15-80


STATE OF KANSAS
STATE CORPORATION COMMISSION
200 Colorado Derby Bldg.
Wichita, Kansas 67202

NOV 23 1982
11-23-82
CONSERVATION DIVISION
Wichita, Kansas

WELL PLUGGING RECORD

Give All Information Completely
Make Required Affidavit

COUNTY Edwards SEC. 12 TWP. 25 RGE. 19 E/W
Location as in quarters or footage from lines:
C NW NW

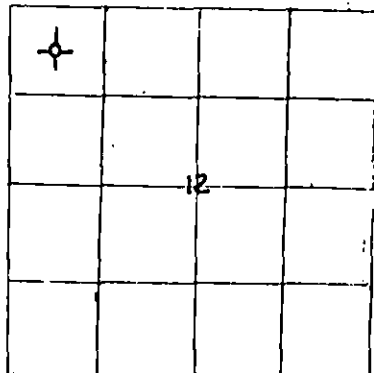

Locate Well
correctly on above
Section Platt.

Lease Owner CINCO EXPLORATION CO.
Lease Name J. H. Moletar Well No. _____
Office Address P. O. Box 3723 Victoria, TX 77903
Character of Well (Completed as Oil, Gas or Dry Hole): DRY
Date Well Completed 11-16-82
Application for plugging filed 11-16-82
Plugging commenced 11-16-82
Plugging completed 11-16-82
Reason for abandonment of well or producing formation _____

Dry Hole
Was permission obtained from the Conservation Division or it's
Agent's before plugging was commenced? Yes

Name of Conservation Agent who supervised plugging of this well Paul Luthi
Producing formation _____ Depth to top _____ bottom T.D. 4730'
Show depth and thickness of all water, oil and gas formations.

OIL, GAS OR WATER RECORDS

Casing Record

Formation	Content	From	To	Size	Put in	Pulled Out
		0'	506'	8 5/8	492'	

Describe in detail the manner in which the well was plugged, indicating where the mud
fluid was placed and the method or methods used in introducing it into the hold. If cement
or other plugs were used, state the character of same and depth placed, from _____ feet
to _____ feet for each plug set.

1st Plug	1320' -- 35 sks
2nd Plug	840' -- 70 sks
3rd Plug	540' -- 4 sks
4th Plug	40' -- 10 sks
Rat Hole	10 sks
Mouse Hole	10 sks

Plugged w/50/50 Pozmix, 4% gel, 3% cc/2.

(If additional description is necessary, use BACK of this sheet)

Name of Plugging Contractor Leben Drilling Co., 105 South Broadway, Ste. 640
Wichita, Ks. 67202


STATE OF Kansas COUNTY OF Sedgwick, ss.
David G. Leben (employee of owner) or (owner or operator) of the
above-described well, being first duly sworn on oath, says: That I have knowledge of the
facts, statements, and matters herein contained and the log of the above-described well as
filed and that the same are true and correct. So help me God.

(Signature) David G. Leben
105 S. Broadway, Ste. 640
(Address) Wichita, Ks. 67202

SUBSCRIBED AND SWORN TO before me this 22 day of November, 19 82

My Commission expires: 08-05-86

Arlene E. Schroer

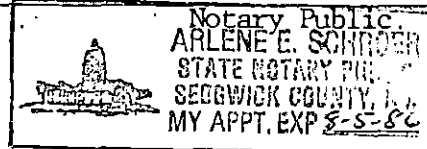

FILL IN WELL LOG AS REQUIRED:

Show all important zones of porosity and contents thereof; cored intervals, and all drill-stem tests, including depth interval tested, cushion used, time tool open, flowing and shut-in pressures, and recoveries.

SHOW GEOLOGICAL MARKERS, LOGS RUN, OR OTHER DESCRIPTIVE INFORMATION.

FORMATION DESCRIPTION, CONTENTS, ETC.	TOP	BOTTOM	NAME	DEPTH
<u>DRILLER'S LOG:</u>				
Sand & Clay	0'	506'		
Clay & Shale	506'	1557'		
Shale	1557'	2470'		
Shale	2470'	3027'		
Shale & Sand	3027'	3405'		
Lime	3995'	4410'		
Lime	4410'	4516'		
Lime	4516'	4626'		
Lime	4626'	4645'		
Lime	4645'	4730'		

STATE CORPORATION COMMISSION
 RECEIVED
 NOV 23 1982
 CONSERVATION DIVISION
 Wichita, Kansas