


Give All Information Completely
Make Required Affidavit
Mail or Deliver Report to:
Conservation Division
State Corporation Commission
800 Bittling Building
Wichita, Kansas

OR

FORMATION PLUGGING RECORD

Strike out upper line
when reporting plug-
ging off formations.

NORTH

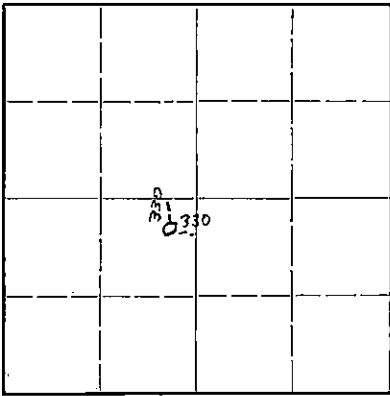

Locate well correctly on above
Section Plat

Stafford

County. Sec. 11 Twp. 25 Rge. 15 (E) (W)

Location as "NE $\frac{1}{4}$ NW $\frac{1}{4}$ SW $\frac{1}{4}$ " or footage from lines. NE of E $\frac{1}{2}$ N $\frac{1}{2}$ of SW $\frac{1}{4}$

Lease Owner. The Winkler-Koch Engineering Co.

Lease Name. R. Wilson

Well No. 1

Office Address. 335 W. Lewis St., Wichita Kans.

Character of Well (completed as Oil, Gas or Dry Hole) Dry Hole

Date well completed. Aug. 17, 1944

19

Application for plugging filed. Aug. 18, 1944

19

Application for plugging approved. Aug. 17, 1944

19

Plugging commenced. Aug. 17, 1944

19

Plugging completed. Aug. 17, 1944

19

Reason for abandonment of well or producing formation. Unable to find oil or gas production in commercial quantities.

If a producing well is abandoned, date of last production. No production

19

Was permission obtained from the Conservation Division or its agents before plugging was commenced? Yes

Name of Conservation Agent who supervised plugging of this well. E. Petty and H. Kerr

Producing formation. Arbuckle Lime Depth to top. 4470 Bottom. 4500 Total Depth of Well. 4500 Feet

Show depth and thickness of all water, oil and gas formations.

OIL, GAS OR WATER RECORDS

CASING RECORD

Formation	Content	From	To	Size	Put In	Pulled Out
Sand	Fresh water	15	160			
Gravel Shale & Sand	None None	160	690			
Sand	Dakota Water	690	800			
Shale & Red Bed	None	800	950			
Anhydrite	None	950	980	10 3/4"	956'	None
Shale & Lime Shells	Salt Water	980	1365			
None Salt & Shale	Salt	1365	1555			
Shale, Lime & Sand	None	1555	T.D.			

Describe in detail the manner in which the well was plugged, indicating where the mud fluid was placed and the method or methods used in introducing it into the hold. If cement or other plugs were used, state the character of same and depth placed, from... feet to... feet for each plug set.


AT Hole circulated and filled with heavy mud from 4500' to 956'

Halliburton bridge plug set on top of mud at 956ft.

25 sacks of cement run on top of bridge through drill pipe by Halliburton pump.

Hole then filled with heavy mud from top of said cement plug at 900' to 25 ft. from top of ground.

Ten sacks of cement run on top of second bridge plug set at 25 ft. from surface and hole was filled to within five feet of surface of ground with cement.

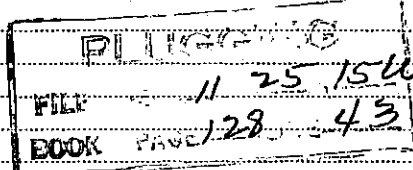

(If additional description is necessary, use BACK of this sheet)

Correspondence regarding this well should be addressed to V. E. Wiggins
Address. Box 191, McPherson Kans.

8-22-44

STATE OF Kansas, COUNTY OF Sedgewick

V. E. Wiggins

(employee of owner) or (owner or operator) of the above-described well,

being first duly sworn on oath, says: That I have knowledge of the facts, statements, and matters herein contained and the log of the above-described well as filed and that the same are true and correct. So help me God.

(Signature)

Box 191, McPherson Ks.

(Address)

Subscribed and Sworn to before me this 21st day of August 1944

My commission expires May 12, 1947

WELL LOG BUREAU — KANSAS GEOLOGICAL SOCIETY
412 Union National Bk. Bldg., Wichita, Kansas


15-185-01050-0000

Company - WOOD RIVER OIL & REFG. CO.
Farm - Bert Wilson No. 1.

SEC. 11 T. 25 R. 15 W
NE SE SW

Total Depth. 4500'
Comm. 7-8-44 Comp. 8-17-44
Shot or Treated.
Contractor. Tri-State Drlg. Co., Inc.
Issued. 9-16-44

County. Stafford
KANSAS

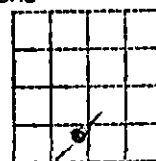

CASING:
10^{5/8}" 956' Cem.

Elevation. _____

Production. Dry

Figures Indicate Bottom of Formations.

cellar	9	Tops:	
sand	150	Topeka	3145
shale & shells	240	K. C.	3774
sand	325	Miss.	4215
shale	340	Kinderhook	4254
red bed & shale	950	Viola	4307
anhydrite	980	Simpson	4395
shale & shells	1365	Arbuckle	4470
salt & shale	1550		
shale	1785		
lime & shale	1865		
lime	1985		
anhydrite	2015		
lime & shale	2050		
lime	2400		
shale & lime	2460		
lime & shale	2675		
lime	2750		
lime & shale	2815		
lime	2925		
lime & shale	3000		
shale & lime	3150		
lime & shale	3225		
shale & lime	3315		
lime & shale	3470		
lime	3660		
shale & lime	3710		
shale	3774		
lime - KC Top	3795		
lime	3977		
lime & shale	4020		
shale & lime	4135		
lime & shale	4181		
Miss lime cherty	4191		
lime & chert	4220		
chert	4253		
shale	4307		
chert	4319		
lime	4353		
lime & chert	4380		
lime sdy	4399		
sand & lime	4434		
sand Simpson	4470		
lime Arbuckle	4475		
lime	4500		
Total Depth			

