


WELL PLUGGING RECORD

Give All Information Completely  
Make Required Affidavit  
Mail or Deliver Report to:  
Conservation Division  
State Corporation Commission  
212 No. Market  
Wichita, Kansas

Edwards County. Sec. 2 Twp. 25S Rge. 16W (N) (W)  
Location as "NE/CNW/SW" or footage from lines C SW  
Lease Owner D. R. Lauck Oil Company, Inc.  
Lease Name Wilson Well No. 1  
Office Address 301 S. Broadway, Wichita, Kansas  
Character of Well (completed as Oil, Gas or Dry Hole) Dry Hole  
Date well completed October 5, 19 66  
Application for plugging filed October 5, 19 66  
Application for plugging approved October 5, 19 66  
Plugging commenced October 5, 19 66  
Plugging completed October 5, 19 66  
Reason for abandonment of well or producing formation Dry Hole

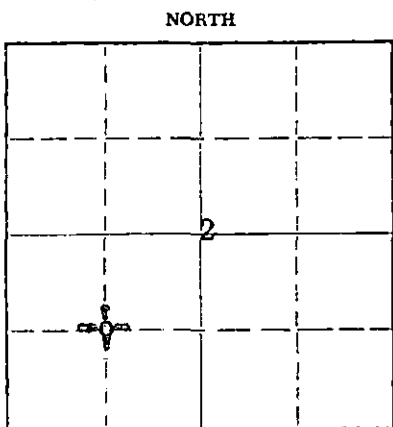

Locate well correctly on above Section Plat

If a producing well is abandoned, date of last production \_\_\_\_\_ 19\_\_\_\_  
Was permission obtained from the Conservation Division or its agents before plugging was commenced? Yes

Name of Conservation Agent who supervised plugging of this well Archie Elving  
Producing formation \_\_\_\_\_ Depth to top \_\_\_\_\_ Bottom \_\_\_\_\_ Total Depth of Well 4356 Feet  
Show depth and thickness of all water, oil and gas formations.

OIL, GAS OR WATER RECORDS

CASING RECORD

FORMATION	CONTENT	FROM	TO	SIZE	PUT IN	PULLED OUT
		0'	300'	8-5/8"	300'	None

Describe in detail the manner in which the well was plugged, indicating where the mud fluid was placed and the method or methods used in introducing it into the hole. If cement or other plugs were used, state the character of same and depth placed, from \_\_\_\_\_ feet to \_\_\_\_\_ feet for each plug set.

4356'-300' Mud  
300'-296' Plug  
296'-256' Cement, 25 sacks  
256'-40' Mud  
40'-36' Plug  
36'-6' Cement, 10 sacks  
(Bottom of Cellar)

RECEIVED  
OCT 17 1966  
SOURCES 10-17-66  
DIVISION  
WICHITA, KANSAS

(If additional description is necessary, use BACK of this sheet)

Name of Plugging Contractor Sun Cementing Co.  
Address Great Bend, Kansas

STATE OF KANSAS, COUNTY OF SEDGWICK, ss.  
John H. Knightley (employee of owner) or (owner or operator) of the above-described

well, being first duly sworn on oath, says: That I have knowledge of the facts, statements, and matters herein contained and the log of the above-described well as filed and that the same are true and correct. So help me God.

(Signature) John H. Knightley  
301 S. Broadway, Wichita, Kansas  
(Address)

SUBSCRIBED AND SWORN TO before me this 12th day of October, 19 66

My commission expires March 12, 1967

Stella J. Lippa  
Notary Public.

15-047-30070-0000

D. R. Lauck Oil Company, Inc.

Wilson #1

C SW Sec. 2-25S-16W  
Edwards County, Kansas

Commenced: September 25, 1966  
Completed: October 5, 1966

Casing Record: 300' 8-5/8" Cemented with 235 sacks Cement,  
5 sacks Calcium Chloride.

Elevation: GL 2065; DF 2068; KB 2070.

Drillers Log

Tops

Sand	198		
Blue Shale	315		Schlumberger
Red Bed	490	Anhydrite	1033+1037
Hard Sand	495	Base Anhydrite	1067+1003
Red Bed & Sand Streaks	840	Topeka	3278-1208
Red Bed	1033	Heebner	3684-1614
Anhydrite	1067	Toronto	3702-1632
Shale shells	1450	Douglas Shale	3720-1650
Shale & shell	1820	Brown Lime	3824-1754
Shale w/lime streaks	2010	Lansing	3832-1762
Lime & shale	2385	Base K.C.	4105-2038
Shale & lime	2535	Marmaton	4152-2082
Lime & shale	2650	Mississippian (reworked)	4245-2175
Shale & lime	3030	Kinderhook Sand	4273-2203
Lime & shale	3470	Kinderhook Shale	4285-2215
Lime	3703	Viola	4349-2279
Broken Lime & shale	3795	Total Depth	4358-2288
Shale	3820		
Lime	4265		
Lime & chert	4275		
Sand & shale	4356		

RTD

DST #1, 4235-75, open 1 hr., strong blow, probably inert gas, recovered 90' mud. ISIP 87#, 30 min. FSIP 121#, 30 min. IFP 78#. FFP 78#.

DST #2, 4272-95, open 1 hr., recovered 15' mud. ISIP 65#, 30 min. FSIP 61#, 30 min. IFP 52#. FFP 52#.

D&A

RECEIVED  
CONSERVATION COMMISSION  
OCT 17 1966  
10-17-66  
CONSERVATION DIVISION  
WILLARD, KANSAS