


STATE OF KANSAS
STATE CORPORATION COMMISSION

Form CP-4

Give All Information Completely
Make Required Affidavit
Mail or Deliver Report to:
Conservation Division
State Corporation Commission
212 No. Market
Wichita, Kansas

WELL PLUGGING RECORD

NORTH

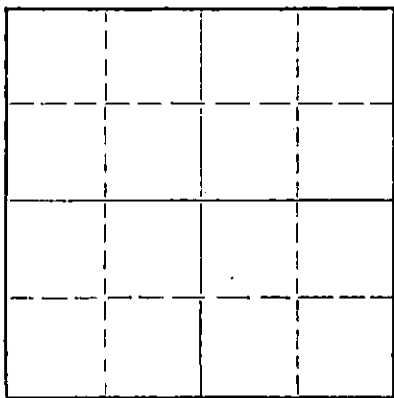

Locate well correctly on above
Section Plat

Edwards County. Sec. 17 Twp. 25S Rge. (E) 16W (W)

Location as "NE/CNW%SW%" or footage from lines C SE NW
Lease Owner BGL Oil Company
Lease Name Johnson Well No. 1
Office Address 10 East 40th St New York, New York
Character of Well (completed as Oil, Gas or Dry Hole) Dry Hole
Date well completed 10-13 1968
Application for plugging filed 10-13 1968
Application for plugging approved 10-13 1968
Plugging commenced 10-13 1968
Plugging completed: 10-13 1968
Reason for abandonment of well or producing formation Dry Hole

If a producing well is abandoned, date of last production 19
Was permission obtained from the Conservation Division or its agents before plugging was commenced? Yes

Name of Conservation Agent who supervised plugging of this well Ralph Warren
Producing formation Depth to top Bottom Total Depth of Well 4486 Feet
Show depth and thickness of all water, oil and gas formations.

OIL, GAS OR WATER RECORDS

CASING RECORD

FORMATION	CONTENT	FROM	TO	SIZE	PUT IN	PULLED OUT
				8 5/8"	237'	

Describe in detail the manner in which the well was plugged, indicating where the mud fluid was placed and the method or methods used in introducing it into the hole. If cement or other plugs were used, state the character of same and depth placed, from feet to feet for each plug set.

Plugged with 50 sacks common @ 500'

Plugged with 25 sacks common @ 237'

Plugged with 10 sacks common @ 40'

RECEIVED
STATE CORPORATION COMMISSION
OCT 28 1968
CONSERVATION DIVISION
Wichita, Kansas

(If additional description is necessary, use BACK of this sheet)
Name of Plugging Contractor Leben Drilling, Inc.
Address Box 486, Great Bend, Kansas

STATE OF KANSAS, COUNTY OF BARTON, ss.
Leslie Kite

(employee of owner) or (owner or operator) of the above-described well, being first duly sworn on oath, says: That I have knowledge of the facts, statements, and matters herein contained and the log of the above-described well as filed and that the same are true and correct. So help me God.

(Signature) Leslie Kite

(Address)

SUBSCRIBED AND SWORN TO before me this 16th day of October 19 68

My commission expires April 1, 1971

Ulanda Nichols Notary Public.

"CORRECTED COPY"

DRILLER'S LOG

COMPANY	BGL Oil Company
CONTRACTOR	LEBEN DRILLING, INC.
FARM	JOHNSON #1
LOCATION	C SE NW SECTION 17-25S-16W
	EDWARDS COUNTY, KANSAS
COMMENCED	10-3-68
COMPLETED	10-13-68

0	195	Sand
195	237	Shale
237	1094	Shale, Red Bed
1094	1108	Anhydrite
1108	1975	Shale
1975	2975	Lime, Shale
2975	3146	Shale, Lime
3146	3839	Lime, Shale
3839	4339	Lime
4339	4380	Chert
4380	4455	Shale, Sand
4455	4486	Chert, Lime
	<u>4486</u>	<u>RTD - D. & A.</u>

RECEIVED
STATE CORPORATION COMMISSION
OCT 28 1968
CONSERVATION DIVISION
Wichita, Kansas

8 5/8" 20# new surface casing set @ 237' cemented with 250 sacks
Common cement, 2% cc

I, Leslie Kite, do hereby certify that the above and foregoing is a true and correct copy of the log of the Johnson #1 Well, located C SE NW of Section 17, Township 25 South, Range 15 West, Edwards County, Kansas, as reflected by the records of Leben Drilling, Inc.

Leslie Kite
Leslie Kite

STATE OF KANSAS)
) SS
COUNTY OF BARTON)

Subscribed and sworn to and before me, a Notary Public, in and for Barton County, Kansas, this 16th day of October, 1968.

Ulanda Nichols
Ulanda Nichols

My Commission Expires:
April 1, 1971