


STATE OF KANSAS
STATE CORPORATION COMMISSION

15-185-00680-0000
WELL PLUGGING RECORD

Give All Information Completely
Make Required Affidavit
Mail or Deliver Report to:
Conservation Division
State Corporation Commission
800 Bitting Building
Wichita, Kansas

Stafford County. Sec. 8 Twp. 25S Rge. 15 (E) (W)
Location as "NE/CNW/SE" or footage from lines. SE $\frac{1}{4}$ SE $\frac{1}{4}$ SE $\frac{1}{4}$
Lease Owner Lion Oil Company
Lease Name Suiter Well No. 1
Office Address Box 639, Pratt, Kansas
Character of Well (completed as Oil, Gas or Dry Hole) Dry Hole
Date well completed March 10, 19 55
Application for plugging filed May 16, 19 55
Application for plugging approved May 17, 19 55
Plugging commenced May 20, 19 55
Plugging completed May 25, 19 55
Reason for abandonment of well or producing formation Dry Hole

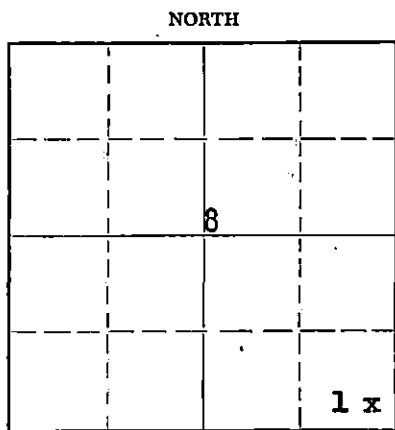

Locate well correctly on above Section Plat

If a producing well is abandoned, date of last production _____ 19 ____
Was permission obtained from the Conservation Division or its agents before plugging was commenced? Yes

Name of Conservation Agent who supervised plugging of this well Warren Horner
Producing formation _____ Depth to top _____ Bottom _____ Total Depth of Well 4600 Feet
Show depth and thickness of all water, oil and gas formations. Plugged Back T. D. - - -4264 "

OIL, GAS OR WATER RECORDS

CASING RECORD

FORMATION	CONTENT	FROM	TO	SIZE	PUT IN	PULLED OUT
				8-5/8"	348'	None
				5-1/2"	4438'	3013'

Describe in detail the manner in which the well was plugged, indicating where the mud fluid was placed and the method or methods used in introducing it into the hole. If cement or other plugs were used, state the character of same and depth placed, from _____ feet to _____ feet for each plug set.

Filled the hole with sand from 4264' to 4195' and ran 5 sacks cement. Mudded the hole to 300', set a 10' rock bridge and ran 20 sacks of cement at 290'. Mudded the hole to 30' and ran 10 sacks of cement on top. Plugging comp.

(If additional description is necessary, use BACK of this sheet)
Name of Plugging Contractor West Supply Co., Inc.
Address Chase, Kansas

STATE OF KANSAS, COUNTY OF PRATT, ss.
Vernon Hayes (employee of owner) or ~~(owner of property)~~ of the above-described well, being first duly sworn on oath, says: That I have knowledge of the facts, statements, and matters herein contained and the log of the above-described well as filed and that the same are true and correct. So help me God.

(Signature) Vernon Hayes
Box 639, Pratt, Kansas
(Address)

SUBSCRIBED AND SWORN TO before me this 28th day of May 19 55

My commission expires August 29, 1955

Van Deubek Notary Public.
RECEIVED
STATE CORPORATION COMMISSION
5-30-55
MAY 30 1955
CONSERVATION DIVISION
Wichita, Kansas

24-2675-5 2-52-20M
PLUGGING
FILE SEC 8 TWP 25S R 15W
BOOK 119 LINE 20

WELL LOG 15-185-00680-0000

COMPANY **LION OIL COMPANY**

SEC. 0 T. 25S R. 15W

FARM **Suitor**

NO. 1

LOC. SE SE SE

TOTAL DEPTH **1600'**

COUNTY **Stafford**

COMM. **9 March 1955**

COMP. **29 March 1955**

CONTRACTOR **GARVEY DRILLING COMPANY**

CASING

**8-5/8" G 345' (300 sz)
5-1/2" G 437' (200 sz)**

ELEVATION **unknown**

PRODUCTION **unknown**

FIGURES INDICATE BOTTOM OF FORMATIONS

175	Sand
345	Shale & Shells
985	Shale & Red Bud
1015	Anhydrite
1075	Shale
1050	Shale & Shells
1920	Lime & Shale
2585	Lime
2720	Lime & Shale
2995	Shale & Shells
3280	Shale
3390	Shale & Lime
3595	Lime & Shale
3650	Lime
3750	Lime & Shale
3855	Shale & Lime
4236	Lime
4293	Cherty Mississippian
4322	Mississippian
4330	Shale & Lime
4407	Lime & Chert
4477	Cherty Viola
4527	Shale & Sand
4546	Sand & Shale
4548	Lime & Shale
4600	Arbuckle
1600	RTD

PLUGGING

FILE SEC 8 T 25 R 15 W

BOOK PAGE 119 LINE 20

5-17-55

RECEIVED
STATE CORPORATION COMMISSION
MAY 17 1955
CONSERVATION DIVISION
Wichita, Kansas

State of MISSOURI
County of STAFFORD

I, Robert F. White of GARVEY DRILLING COMPANY

upon oath state that the above and foregoing is a true and correct copy of the log of the SI SUITOR well.

Subscribed and sworn to before me this 5th day of April 1955

My Commission Expires: 11 August 1958

Robert F. White
Robert F. White
NOTARY PUBLIC