

STATE OF KANSAS
STATE CORPORATION COMMISSION


WELL PLUGGING RECORD

Give All Information Completely
Make Required Affidavit
Mail or Deliver Report to
Conservation Division
State Corporation Comm.
245 North Water
Wichita, KS 67202

Stafford County, Sec. 21 Twp. 25S Rge. 15W E/W
Location as "NE/CNW $\frac{1}{4}$ SW $\frac{1}{4}$ " or footage from lines

App. C NE NE

Lease Owner Barnett Oil, Inc.
Lease Name Smith "B" #1 Well No. 1
Office Address 1625 Vickers/KSB Building, Wichita, Ks 67202
Character of Well (Completed as Oil, Gas or Dry Hole)
Dry Hole

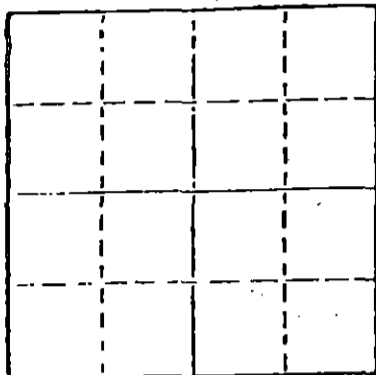

Locate well correctly on above Section Plat

Date Well completed April 1, 1977 19
Application for plugging filed March 31, 1977 19
Application for plugging approved March 31, 1977 19
Plugging commenced 1:00 AM, April 1, 1977 19
Plugging completed 3:00 AM, April 1, 1977 19
Reason for abandonment of well or producing formation
Dry Hole

If a producing well is abandoned, date of last production 19

Was permission obtained from the Conservation Division or its agents before plugging was commenced? Yes

Name of Conservation Agent who supervised plugging of this well J. H. Metz
Producing formation _____ Depth to top _____ Bottom _____ Total Depth of Well 4270'
Show depth and thickness of all water, oil and gas formations.

OIL, GAS OR WATER RECORDS

CASIN; RECORD

FORMATION	CONTENT	FROM	TO	SIZE	PUT IN	PULLED OUT
				8 5/8"	329'	None

Describe in detail the manner in which the well was plugged, indicating where the mud fluid was placed and the method or methods used in introducing it into the hold. If cement or other plugs were used, state the character of same and depth placed, from _____ feet to _____ feet for each plug set.

Filled hole with heavy mud.
Heavy mud to 340' with 35 sacks regular cement thru drill pipe; heavy mud to 40', 1/2 sack hulls, solid bridge; 15 sacks to surface; 5 sacks in rat-hole.
4-20-77
RECEIVED
STATE CORPORATION COMMISSION
APR 20 1977

CONSERVATION DIVISION
Wichita, Kansas

(If additional description is necessary, use BACK of this sheet)

Name of Plugging Contractor Sterling Drilling Company
P. O. Box 129, Sterling, Kansas 67579

STATE OF KANSAS COUNTY OF RICE ss.
F. A. Wuellner (employee of owner) or (owner or operator) of the above-described


well, being first duly sworn on oath, says: That I have knowledge of the facts, statements, and matters herein contained and the log of the above-described well as filed and that the same are true and correct. So help me God. STERLING DRILLING COMPANY

(Signature) F. A. Wuellner
F. A. Wuellner, Secretary
P. O. Box 129, Sterling, Kansas
(Address)

Subscribed and sworn to before me this 2nd day of April 19 77

CHARLES HALL—NOTARY PUBLIC
My Commission Expires Jan. 6, 1978

Charles M. Hall
Charles M. Hall, Notary Public.

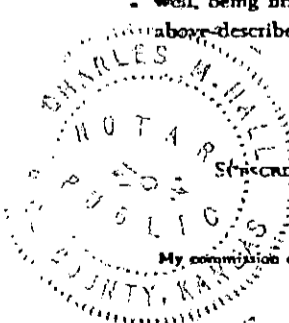

15-185-20717-0000

STERLING DRILLING COMPANY
P. O. Box 129
Sterling, Kansas 67579

WELL LOG ----- SMITH "B" #1
Located: App. NE NE, Section 21-25S-15W, Stafford County,
Kansas

OWNER: Barnett Oil, Inc.
ROTARY DRILLING CONTRACTOR: Sterling Drilling Company

COMMENCED: March 25, 1977
COMPLETED: March 31, 1977

TOTAL DEPTH: 4270'

<u>LOG</u>		<u>CASING RECORD</u>
0 - 200	Clay, Sand and Gravel	Ran 9 joints, 8 5/8", 28#, 8V, Rge #3, used casing, 318' set at 329' K.B. with 300 sacks Common, 2% gel, 3% cc. Plug down at 2:30 PM, 3-25-77.
200 - 295	Blue Shale	
295 - 330	Red Bed	
330 - 982	Anhydrite	
982 - 1360	Shale	
1360 - 2015	Shale and Shells, Salt	
2015 - 2042	Shale and Lime Strgs.	
2042 - 3639	Shale and Lime	
3639 - 3645	Shale (Heebner)	
3645 - 3792	Lime and Shale	
3792 - 3804	B. Lime	
3804 - 3840	Lime	
3840 - 3935	Lime and Shale	
3935 - 4135	Lime	
4135 - 4215	Lime and Shale	
4215 - 4253	Lime, Shale and Chert	
4253 - 4270	Chert and Lime	Plugged.

4-20-77
RECEIVED
STATE CORPORATION COMMISSION
APR 20 1977
CONSERVATION DIVISION
Wichita, Kansas