


STATE OF KANSAS  
STATE CORPORATION COMMISSION  
Give All Information Completely  
Make Required Affidavit  
Mail or Deliver Report to:  
Conservation Division  
State Corporation Commission  
211 No. Broadway  
Wichita, Kansas

WELL PLUGGING RECORD

Stafford County, Sec. 22 Twp. 25 Rge. (E) 15 (W)

Location as "NE/CNW\*SW\*" or footage from lines NW NW SE  
Lease Owner Isern-Wells  
Lease Name Haynes Well No. #1  
Office Address Box 486, Ellinwood, Kansas  
Character of Well (completed as Oil, Gas or Dry Hole) oil  
Date well completed December 17 1958  
Application for plugging filed April 15 1963  
Application for plugging approved 19  
Plugging commenced April 15 1963  
Plugging completed April 24 1963  
Reason for abandonment of well or producing formation depleted

NORTH

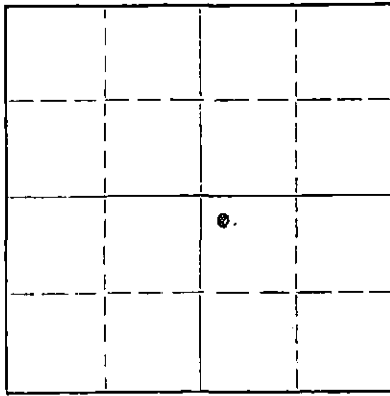

Locate well correctly on above Section Plat

If a producing well is abandoned, date of last production Feb. 1963  
Was permission obtained from the Conservation Division or its agents before plugging was commenced? yes

Name of Conservation Agent who supervised plugging of this well W. L. Lackamp  
Producing formation Mississippi lime Depth to top Bottom Total Depth of Well 4578 Feet  
Show depth and thickness of all water, oil and gas formations.

OIL, GAS OR WATER RECORDS

CASING RECORD

FORMATION	CONTENT	FROM	TO	SIZE	PUT IN	PULLED OUT
		0	360	8 5/8	360	none
		0	4578	5 1/2	4578	3542.03

Describe in detail the manner in which the well was plugged, indicating where the mud fluid was placed and the method or methods used in introducing it into the hole. If cement or other plugs were used, state the character of same and depth placed, from \_\_\_\_\_ feet to \_\_\_\_\_ feet for each plug set.

Pushed plug to 4220', set 10' rock bridge. Mixed 5 sacks of cement and dumped at 4210'. Pushed plug to 225', set 10' rock bridge, and dumped 20 sacks of cement. Filled with mud to 40', set 10' rock bridge, and capped with 10 sacks of cement.

RECEIVED  
STATE CORPORATION COMMISSION

APR 26 1963

CONSERVATION DIVISION  
Wichita, Kansas

(If additional description is necessary, use BACK of this sheet)

Name of Plugging Contractor Pipe Pullers, Inc.  
Address Box 486, Ellinwood, Kansas

STATE OF Kansas, COUNTY OF Barton, ss.  
Dean Wells (employee of owner) or (owner) of the above-described well, being first duly sworn on oath, says: That I have knowledge of the facts, statements, and matters herein contained and the log of the above-described well as filed and that the same are true and correct. So help me God.

(Signature) *Dean Wells*  
Ellinwood, Kansas  
(Address)

SUBSCRIBED AND SWORN to before me this 25th day of April, 1963

My commission expires July 7, 1964

Notary Public.



WELL LOG

IHERN BROTHERS ET AL, OWNER - HAYNES #1  
 NW NW SE Section 22, Township 25, Range 15W  
 Stafford County, Kansas

Figures indicate bottom of formations:

ELEVATION: 2024' KB

PIPE RECORD:

8 5/8" set at 360'  
 cemented with 250 sacks cement  
 5 1/2" set at 4579'  
 cemented with 150 sacks cement

Rotary Commenced 12-1-58  
 Completed 12-17-58

GEOLOGICAL TOPS:

Anhydrite (drlr) 972  
 Heebner 3643  
 Brown Lime 3797  
 Lansing 3808  
 Mississippi 4239  
 Kinderhook 4277  
 Viola 4370  
 Simpson 4470  
 Arbuckle 4531

0 to 10 Cellar  
 215 Sand  
 320 Shale  
 360 Red Rock  
 972 Red Bedl  
 990 Anhydrite  
 1440 Shale and shells  
 1600 salt  
 1890 Shale and shells  
 2570 lime and shale  
 3355 shale and shells  
 3646 Lime and shale  
 3653 Heebner shale  
 3685 Lime and shale  
 3798 Shale  
 3802 Lime  
 4265 Lime and shale  
 4275 Chat  
 4402 Chert and lime  
 4540 Lime and shale  
 4580 Lime  
 4580 RTD

RECEIVED  
 STATE CORPORATION COMMISSION

APR 26 1963

CONSERVATION DIVISION  
 Wichita, Kansas

STATE OF KANSAS )  
 COUNTY OF BARTON ) SS

I, M. M. Shropshire, Drilling Superintendent of the above-described well, being first duly sworn on oath, declare: That I have knowledge of the facts, statements and matters herein contained pertaining to the log of the above-described well, as filed, and that the same are true and correct.

M. M. Shropshire

Subscribed and Sworn to before me this 29th day of December, 1958.

George A Meyer  
 Notary Public

My commission expires February 10, 1959.