

WELL PLUGGING RECORD

Give all Information Completely
Make Required Affidavit
Mail or Deliver Report to:
Conservation Division
State Corporation Commission
211 No. Broadway
Wichita, Kansas

Finney County. Sec. 17 Twp. 26 Rge. ~~28~~ 31 (W)

Location as "NE/CNW&SW&" or footage from lines C NE

Lease Owner Kansas-Nebraska Natural Gas Company, Inc.

Lease Name Brensing Well No. 2

Office Address P. O. Box 608, Hastings, Nebraska 68901

Character of Well (completed as Oil, Gas or Dry Hole) Gas

Date well completed July 16 19 57

Application for plugging filed April 2 19 65

Application for plugging approved April 5 19 65


Plugging commenced May 21 19 65

Plugging completed May 21 19 65

Reason for abandonment of well or producing formation No longer capable of commercial production due to water

If a producing well is abandoned, date of last production March 19 64

Was permission obtained from the Conservation Division or its agents before plugging was commenced? ~~XXXXXXXXXX~~ Yes

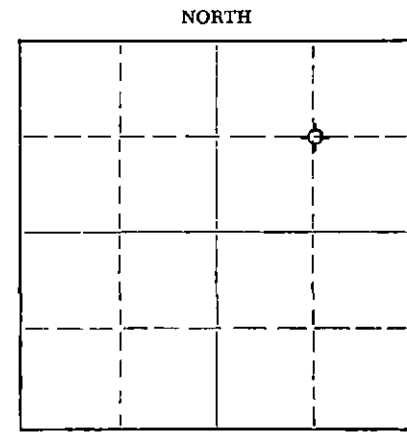

Locate well correctly on above Section Plat

Name of Conservation Agent who supervised plugging of this well Hugh Scott

Producing formation Chase Group Depth to top 2614 Bottom 2675 Total Depth of Well 2704 Feet

Show depth and thickness of all water, oil and gas formations.

OIL, GAS OR WATER RECORDS

CASING RECORD

FORMATION	CONTENT	FROM	TO	SIZE	PUT IN	PULLED OUT
Herrington	Gas	2600	2624	8-5/8"	447	0
Krider	Gas	2640	2652	5-1/2"	2694	1842
L. Krider	Gas	2671	2675			

Describe in detail the manner in which the well was plugged, indicating where the mud fluid was placed and the method or methods used in introducing it into the hole. If cement or other plugs were used, state the character of same and depth placed, from _____ feet to _____ feet for each plug set.

Mixed 20 sacks of cement with pump truck and pumped to 2545. Shot pipe at 1842' and worked loose.

Mixed 35 sacks of cement with pump truck and pumped 450' to 350'.

Pulled remainder of casing, 60 joints total.

Top plug 15 sacks 45' to 0' in 8-5/8" casing

RECEIVED
STATE CORPORATION COMMISSION

JUN 2 1965
6/2/65
CONSERVATION DIVISION
Wichita, Kansas

(If additional description is necessary, use BACK of this sheet)

Name of Plugging Contractor Sargent's Casing Pulling Service

Address Liberal, Kansas

STATE OF Nebraska, COUNTY OF Adams, ss.

Thomas C. Swanson (employee of owner) ~~not owner or operator~~ of the above-described well, being first duly sworn on oath, says: That I have knowledge of the facts, statements, and matters herein contained and the log of the above-described well as filed and that the same are true and correct. So help me God.

(Signature) Thomas C. Swanson

Box 608 HASTINGS NEBRASKA
(Address)

SUBSCRIBED AND SWORN TO before me this 1st day of June, 19 65

My commission expires January 23, 1970

F. S. White
Notary Public.



15-055-00637-0000

COMPANY - Kansas-Nebraska Natural Gas Co.

FARM - Bremsing No. 2

CONTRACTOR - Fees Drilling Company

LOC. - C/NW/4
Sec. 17-26-31
Finney, County,
Kansas

COMMENCED: 6-17-57

ELEVATION:

COMPLETED: 6-23-57

PRODUCTION: Gas

TOTAL DEPTH: 2694 ft.

CASING: 460' of 8 5/8", cem. w/250 sacks poz. mix
2694' of 5 1/2", cem. w/150 sacks poz. mix

FROM	TO	
0	71	surface soil
71	380	sand & gravel
380	454	blue shale w/lime streaks
454	825	shale & sand
825	1072	red bed & gyp
1072	1316	red bed & shale
1316	1916	salt, red bed & shale
1916	1955	shale & anhydrite
1955	2289	lime & shale
2289	2365	shale & lime
2365	2491	lime & shale
2491	2591	lime & shale
2591	2671	shale & lime
2671	2705	lime & shale

7-1-65
RECEIVED
STATE CORPORATION COMMISSION

JUL 1 1965

CONSERVATION DIVISION
Wichita, Kansas