


15-055-00635-0000

STATE OF KANSAS
STATE CORPORATION COMMISSION
CONSERVATION DIVISION
P. O. BOX 17027
WICHITA, KANSAS 67217

FORM CP-4

WELL PLUGGING RECORD

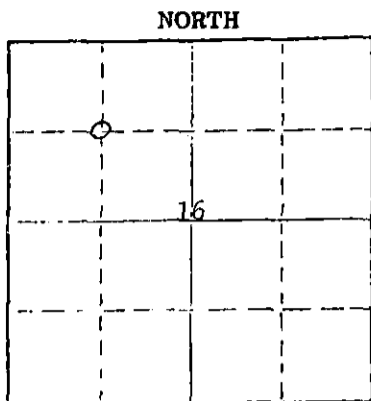

Locate well correctly on above Section Plot

Finney County, Sec. 16 Twp. 26S Rge. 31W (E) (W)
 Location as "NE/CNW/SW" or footage from lines. C NW 1/4
 Lease Owner. Graham-Michaelis Corporation
 Lease Name. Vanderee Well No. 1
 Office Address. P. O. Box 247, Wichita, Kansas 67201
 Character of Well (completed as Oil, Gas or Dry Hole). Gas
 Date well completed. Nov. 21, 1955
 Application for plugging filed. Sept 25, 1975
 Application for plugging approved. Sept 26, 1975
 Plugging commenced. 10-15 1975
 Plugging completed. 10-16 1975
 Reason for abandonment of well or producing formation. Non-Commercial
 If a producing well is abandoned, date of last production. August, 1975
 Was permission obtained from the Conservation Division or its agents before plugging was commenced? Yes

Name of Conservation Agent who supervised plugging of this well. Clarence Thomas
 Producing formation. Krider Depth to top. 2625 Bottom. 2670 Total Depth of Well 2678
 Show depth and thickness of all water, oil and gas formations.

OIL, GAS OR WATER RECORDS

CASING RECORD

FORMATION	CONTENT	FROM	TO	SIZE	PUT IN	PULLED OUT
				4 1/2		732
				8 5/8	507'	none

Describe in detail the manner in which the well was plugged, indicating where the mud fluid was placed and the method or methods used in introducing it into the hole. If cement or other plugs were used, state the character of same and depth placed, from _____ feet to _____ feet for each plug set.

Pumped 2 sks. of hulls & 15 sks. of cement to 2500 W/ 500 lbs.
 Pumped 35 sks. of cement @ 500 to 400 ft.
 Put Bridge & 15 sks. of cement @ 45' to 0'

10-28-75 OCT 28 1975

(If additional description is necessary, use BACK of this sheet)
 Name of Plugging Contractor. Sargents Casing Pulling Service Kansas No. 511
 Address. Box 506 Liberal, Kansas 67901

STATE OF Kansas COUNTY OF Sedgwick
 Jack L. Yinger (employee of owner) or (owner or operator) of the above-described

well, being first duly sworn on oath, says: That I have knowledge of the facts, statements, and matters herein contained and the log of the above-described well as filed and that the same are true and correct. So help me God.

(Signature) Jack L. Yinger
 P. O. Box 247, Wichita, Kansas 67201
 (Address)

SUBSCRIBED AND SWORN to before me this 27th day of October, 1975

My commission expires
 MURIEL F. C. JERAM
 NOTARY PUBLIC
 SEDGWICK COUNTY, KANSAS
 MY COMMISSION EXPIRES
 JULY 25, 1976

Muriel F. C. Jeram
 Notary Public.

No. 1 VANDERREE

15-055-66635-0000

Well Record:

Location: Sec. 16-26S-31W
 Finney County, Kansas

Operator: Michaelis Drilling Company
 1019 East Second Street
 Wichita, Kansas

Contractor: Michaelis Drilling Company
 1019 East Second Street
 Wichita, Kansas

Commenced: November 1, 1955
 Completed: November 6, 1955
 Elevation: 2816' D.F.

Casing Record: 8-5/8" @ 507' w/300 sacks cement
 4-1/2" @ 2677' w/400 sacks cement

LOG

Clay	49	
Gravel & Sand	107	
Sand & Clay	253	
Yellow Clay	370	
Sand & Shale	495	
Blue Shale	820	
Shale & Red Bed	1375	
Sand	1540	
Shale & Red Bed	1690	
Red Bed	1739	
Sand	1815	
Red Bed w/s Gyp	1890	
Shale & Anhydrite	2655	
Anhydrite	2678	RTD
Top of Herrington	2599	
Upper Krider	2625	
Lower Krider	2648	

STATE OF KANSAS)
) ss.
 COUNTY OF SEDGWICK)

The undersigned, MICHAELIS DRILLING COMPANY, hereby certifies that the above log is a true and correct log of the formations encountered in drilling the above well as reflected by the daily drilling report.

MICHAELIS DRILLING COMPANY

By W. A. Michaelis, Jr.
 W. A. Michaelis, Jr.
 Managing Partner

Subscribed and sworn to before me
 this 1st day of December, 1955.

Mary L. Barnes
 Mary L. Barnes, Notary Public

My commission expires
 November 7, 1957.

9-26-75