


15-069-00004-2000

STATE OF KANSAS  
STATE CORPORATION COMMISSION

Give All Information Completely  
Make Required Affidavit  
Mail or Deliver Report to:  
Conservation Division  
State Corporation Commission  
211 No. Broadway  
Wichita, Kansas

WELL PLUGGING RECORD

NORTH

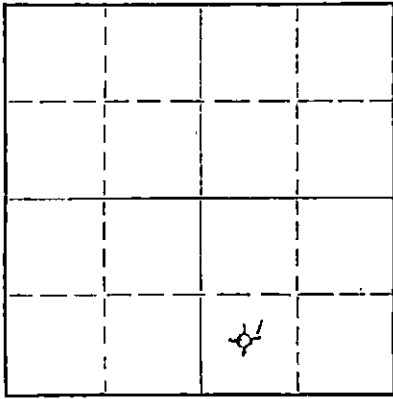

Locate well correctly on above  
Section Plat

Gray County. Sec. 20 Twp. 26S Rge. (E) 29 (W)  
Location as "NE/CNW/SW" or footage from lines 1975' from East & 660' from South.  
Lease Owner Phillips Petroleum Company  
Lease Name Jury A Well No. 1  
Office Address Box 241 Guymon, Oklahoma  
Character of Well (completed as Oil, Gas or Dry Hole) Dry Hole  
Date well completed March 13, 1960 19  
Application for plugging filed March 14, 1960 19  
Application for plugging approved Verbal approval March 13, 1960 19  
Plugging commenced March 13, 1960 19  
Plugging completed March 14, 1960 19  
Reason for abandonment of well or producing formation Dry Hole

If a producing well is abandoned, date of last production None 19  
Was permission obtained from the Conservation Division or its agents before plugging was commenced? Yes

Name of Conservation Agent who supervised plugging of this well W. L. La Kamp  
Producing formation none Depth to top \_\_\_\_\_ Bottom \_\_\_\_\_ Total Depth of Well 6088' Feet  
Show depth and thickness of all water, oil and gas formations.

OIL, GAS OR WATER RECORDS

CASING RECORD

FORMATION	CONTENT	FROM	TD	SIZE	PUT IN	PULLED OUT
Lansing, K. C.	Salt Water	4490	4520	13-3/8"	200'	None
Mississippi	Salt Water	4975	5010	9-5/8"	2200'	None
Arbuckle	Salt Water	5970	6011			

Describe in detail the manner in which the well was plugged, indicating where the mud fluid was placed and the method or methods used in introducing it into the hole. If cement or other plugs were used, state the character of same and depth placed, from \_\_\_\_\_ feet to \_\_\_\_\_ feet for each plug set.

Hole standing full of mud. Ran 5 joints of 2-3/8" OD tubing open ended on drill pipe. Spotted 50 sack cement plug from 6050' to 5950'. Spotted 45 sack cement plug from 5000' to 4900'. Spotted 44 sack cement plug from 4600' to 4500'. Spotted 44 sack cement plug from 2250' to 2150' (50' into bottom of 9-5/8" casing). Spotted 17 sack cement plug from 35' to bottom of cellar in top of 9-5/8" casing. Cut off 3' below ground level and welded steel plate on top of 13-3/8" casing.

3-28-60  
RECEIVED  
MAR 28 1960  
CONSERVATION DIVISION  
Wichita, Kansas

(If additional description is necessary, use BACK of this sheet)  
Name of Plugging Contractor J. M. Johnson Drilling Co., drilling contractor.  
Address Combs-Worley Building Pampa, Texas

STATE OF Oklahoma, COUNTY OF Texas, ss.  
F. R. Holtzapple (employee of owner) or (owner or operator) of the above-described well, being first duly sworn on oath, says: That I have knowledge of the facts, statements, and matters herein contained and the log of the above-described well as filed and that the same are true and correct. So help me God.

(Signature) F. R. Holtzapple  
Box 241 Guymon, Oklahoma  
(Address)

SUBSCRIBED AND SWORN TO before me this 15 day of March, 19 60

My commission expires September 10, 1960 Notary Public.