

15-069-20094-0000


STATE OF KANSAS
STATE CORPORATION COMMISSION

WELL PLUGGING RECORD

Give All Information Completely
Make Required Affidavit
Mail or Deliver Report to
Conservation Division
State Corporation Comm.
245 North Water
Wichita, KS 67202

Gray County, Sec. 21 Twp. 26 Rge. 27W ~~Exx~~
Location as "NE/CNW $\frac{1}{4}$ SW $\frac{1}{4}$ " or footage from lines
NW NW NW

Lease Owner Gear Petroleum Company, Inc.
Lease Name Nolan Well No. 1
Office Address 300 Sutton Place, Wichita, Kansas 67202
Character of Well (Completed as Oil, Gas or Dry Hole)
Dry Hole

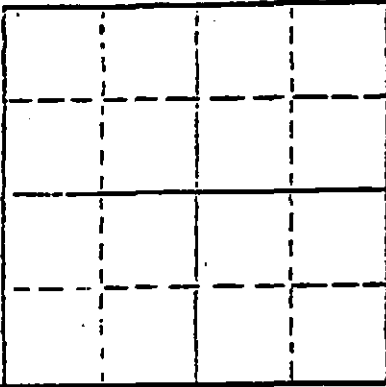

Locate well correctly on above
Section Plot

Date Well completed 12/15/80 19
Application for plugging filed 12/15/80 19
Application for plugging approved 12/15/80 19
Plugging commenced 12/15/80 19
Plugging completed 12/15/80 10:15 a.m. 19
Reason for abandonment of well or producing formation

If a producing well is abandoned, date of last production 19

Was permission obtained from the Conservation Division or
its agents before plugging was commenced? Yes

Name of Conservation Agent who supervised plugging of this well Clarence Thomas, Jr.
Producing formation Depth to top Bottom Total Depth of Well
Show depth and thickness of all water, oil and gas formations. RTD 5700'

OIL, GAS OR WATER RECORDS

CASING RECORD

FORMATION	CONTENT	FROM	TO	SIZE	PUT IN	PULLED OUT
	Surface	0	431'	8-5/8"	yes	no

Describe in detail the manner in which the well was plugged, indicating where the mud flu:
was placed and the method or methods used in introducing it into the hold. If cement or oth:
plugs were used, state the character of same and depth placed, from feet to
feet for each plug set.

1st plug @ 540' with 50 sacks

Bridge @ 40' with 10 sacks

5 sacks in rathole

Job complete @ 10:15 a.m. 12/15/80

RECEIVED
JAN 6 1981
1-6-81
CONSERVATION DIVISION
Wichita, Kansas

(If additional description is necessary, use BACK of this sheet)

Name of Plugging Contractor Slawson Drilling Company, Inc.

STATE OF Kansas COUNTY OF Sedgwick, ss.
James C. Remsberg, Slawson Drilling Co., Inc. (employee of owner) or (owner or operator)
of the above-described well, being first duly sworn on oath, says: That I have knowledge of
the facts, statements, and matters herein contained and the log of the above-described well
is filed and that the same are true and correct. So help me God.


(Signature)

James C. Remsberg
200 Douglas Building, Wichita, Kansas 67202
(Address)

SUBSCRIBED AND SWORN TO before me this 31st day of December, 19 80

Mary Lou Taylor
Notary Public.

My commission expires January 17, 1985

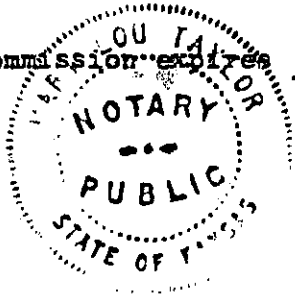

15-069-20094-0000

DRILLERS LOG

OPERATOR: Gear Petroleum Company, Inc.
 300 Sutton Place
 Wichita, Kansas 67202

WELL NAME: Nolan #1
 NW NW NW Sec. 21-26S-27W
 Gray County, Kansas

CONTRACTOR: Slawson Drilling Company, Inc.
 200 Douglas Building
 Wichita, Kansas 67202

COMMENCED: 12/4/80

COMPLETED: 12/15/80

RTD: 5700'

SURFACE CASING: 8-5/8" set at 431' with 325 sx cement

0' to 435' Sand & Shale
 435' to 900' Shale & Sand
 900' to 1657' Sand & Shale
 1657' to 1685' Anhydrite
 1685' to 1950' Sand & Shale
 1950' to 2743' Shale
 2743' to 4990' Lime & Shale
 4990' to 5142' Lime
 5142' to 5345' Lime & Shale
 5345' to 5375' Lime
 5375' to 5545' Lime & Shale
 5545' to 5700' Lime
 RTD 5700'

STATE OF KANSAS
 COUNTY OF SEDGWICK

I, James C. Remsberg, of the Slawson Drilling Company, Inc. hereby state the above is an accurate copy of the Nolan #1 log for Gear Petroleum Company, Inc.

James C. Remsberg
 James C. Remsberg

Subscribed and sworn to
 me this 31st day of December, 1980
Mary Lou Taylor
 Mary Lou Taylor, Notary

My commission expires January 17, 1985

1-6-81
 RECEIVED
 STATE CONSERVATION COMMISSION
 JAN 6 1981
 CONSERVATION DIVISION
 Wichita, Kansas

