


WELL PLUGGING RECORD

Give All Information Completely
Make Required Affidavit
Mail or Deliver Report to:
Conservation Division
State Corporation Commission
800 Bitting Building
Wichita, Kansas

Ford County. Sec. 34 Twp. 26S Rge. 26 (W) W (W)
Location as "NE/CNW $\frac{1}{4}$ SW $\frac{1}{4}$ " or footage from lines C NW/4 NE/4 SE/4
Lease Owner Deep Rock Oil Corporation
Lease Name H.A. Kinkaid Well No. 1
Office Address Box 1051, Tulsa, Oklahoma
Character of Well (completed as Oil, Gas or Dry Hole) Dry Hole
Date well completed July 19 19 52
Application for plugging filed July 21 19 52
Application for plugging approved July 21 19 52
Plugging commenced July 19 19 52
Plugging completed July 19 19 52
Reason for abandonment of well or producing formation Dry Hole

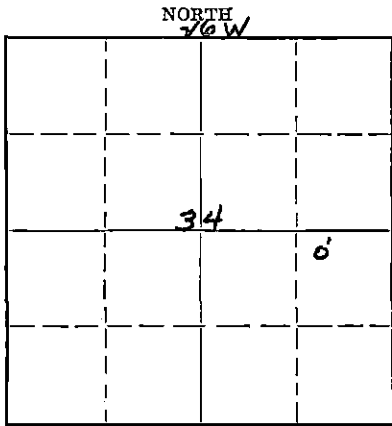

Locate well correctly on above
Section Plat

If a producing well is abandoned, date of last production 19
Was permission obtained from the Conservation Division or its agents before plugging was commenced? Yes

Name of Conservation Agent who supervised plugging of this well Mr. M.A. Rives
Producing formation Depth to top Bottom Total Depth of Well 5465' Feet
Show depth and thickness of all water, oil and gas formations.

OIL, GAS OR WATER RECORDS

CASING RECORD

Formation	Content	From	To	Size	Put In	Pulled Out
				13-3/8"	278'	None

Describe in detail the manner in which the well was plugged, indicating where the mud fluid was placed and the method or methods used in introducing it into the hole. If cement or other plugs were used, state the character of same and depth placed, from feet to feet for each plug set.

Filled with heavy mud to 270', set Halliburton wood plug, put in 1/2 sack hulls and ran 25 sacks cement. Put in heavy mud and filled to 20'. Set wood plug and mixed and pumped in 20 sacks cement, filled to top of hole and into cellar.

(If additional description is necessary, use BACK of this sheet)

Name of Plugging Contractor R.W. Rine Drilling Company
Address 320 Central Building, Wichita, Kansas

STATE OF Kansas, COUNTY OF Reno, ss.
Jack Smith (employee of owner) or (owner/operator) of the above-described well, being first duly sworn on oath, says: That I have knowledge of the facts, statements, and matters herein contained and the log of the above-described well as filed and that the same are true and correct. So help me God.

(Signature) *Jack Smith*
Box #1146, Hutchinson, Kansas (Address)

SUBSCRIBED AND SWORN TO before me this 25th day of July, 19 52

My commission expires September 28, 1955

23-8390-s 6-51-20M
RECEIVED
CORPORATION COMMISSION
FILE SEC 34 T 26 R Xcc
EGOK PAGE 36 LINE 27
JUL 26 1952 7-26-52
WICHITA, KANSAS

15-057-00086-0000

SW NE SE
Sec. 54-26S-26W
FORD COUNTY, KANSAS

KINKAID WELL No. 1

CONTRACTOR: THE R. W. RINE DRILLING COMPANY
STARTED: JUNE 19, 1952 FINISHED: JULY 19, 1952

LOG

SURFACE SAND AND SHALE	0 - 230	
SAND AND SHALE	230 - 285	13-3/8" Csg. @ 278' w/325 sx. COMMON w/3 sx. CC
SAND, SHALE AND SHELLS	285 - 550	
SAND AND SHALE	550 - 900	Syfo @ 650' - 1°
RED BED	900 - 995	
ANHYDRITE	995 - 1045	Syfo @ 1000' - OK
SHALE AND SHELLS	1045 - 2290	Syfo @ 2100' - 1-3/4°
SHALE	2290 - 2470	
SHALE AND LIME	2470 - 2545	Syfo @ 2500' - 2 1/2°
SHALE AND SHELLS	2545 - 2625	Syfo @ 2520' - 1-3/4°
SHALE AND SAND	2625 - 2650	
LIME	2650 - 2713	
LIME AND SHALE	2713 - 2828	
LIME	2828 - 2840	
SHALE AND LIME	2840 - 2915	
LIME	2915 - 3085	Syfo @ 2980' - 1-3/4°
SHALE AND LIME	3085 - 3170	
LIME	3170 - 3220	
LIME AND SHALE	3220 - 3320	
LIME	3320 - 3400	Syfo @ 3350' - 3/4°
LIME AND SHALE	3400 - 3515	
LIME AND SHALE	3515 - 3610	
LIME	3610 - 3678	
LIME AND SHALE	3678 - 3746	
LIME	3746 - 4220	
LIME AND SHALE	4220 - 4275	DROPPED GO DEVIL
LIME	4275 - 4343	
LIME AND SHALE	4343 - 4385	
LIME	4385 - 4622	Syfo @ 4498 - 1/2°
LIME	4622 - 4724	
LIME AND SHALE	4724 - 4760	
LIME	4760 - 4868	Syfo @ 4794 - 1°
LIME AND SAND	4868 - 4900	
LIME	4900 - 5032	
LIME	5032 - 5115	
SANDY LIME	5115 - 5142	Syfo @ 5142 - 1-3/4°
LIME AND CHERT	5142 - 5168	
LIME	5168 - 5465	RTD D&A @ 5465

BOTTOM PLUG @ 270' w/1/2 sx. HULLS
AND 25 SKS. CEMENT.
TOP PLUG @ 40' w/20' SKS CEMENT
HEAVY MUD BETWEEN PLUGS.

I, R. M. GREEN, DO HEREBY CERTIFY THAT THE ABOVE IS A TRUE AND ACCURATE LOG OF THE
KINKAID WELL No. 1, LOCATED SW NE SE, SEC. 54-26S-26W, FORD COUNTY, KANSAS.

R. M. Green
ASSISTANT SECRETARY

SUBSCRIBED TO AND SWORN BEFORE ME THIS 24TH DAY OF JULY, 1952.

Leonard Pederson
NOTARY PUBLIC

MY COMMISSION EXPIRES APRIL 20, 1955.

RECEIVED
CORPORATION COMMISSION
PLUGGING
FILE SEC 26T 26W 26
PAGE 51 LINE 5127

7-25-52
RECEIVED
JUL 25 1952
Hutchinson, Kansas