


STATE OF KANSAS
STATE CORPORATION COMMISSION

WELL PLUGGING RECORD

Give All Information Completely
Make Required Affidavit
Mail or Deliver Report to:
Conservation Division
State Corporation Commission
212 North Market, Insurance Bldg.
Wichita, Kansas

Edwards County. Sec. 16 Twp. 25S Rge. 16 XX (W)
Location as "NE/CNW/SW" or footage from lines C SW SW
Lease Owner D.R. Oil Company, Inc; N C R A
Lease Name Palmitier Well No. 1
Office Address 301 So. Broadway Wichita Kansas
Character of Well (completed as Oil, Gas or Dry Hole) dry hole
Date well completed June 28 19 60
Application for plugging filed June 28 19 60
Application for plugging approved June 28 19 60
Plugging commenced June 28 19 60
Plugging completed June 28 19 60
Reason for abandonment of well or producing formation dry hole

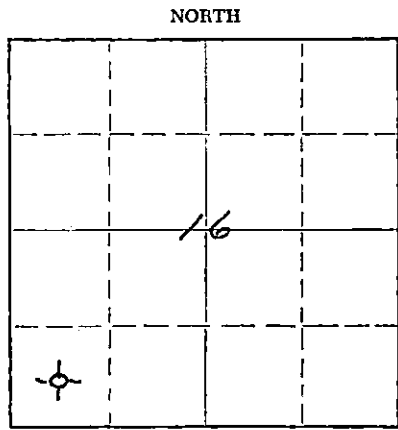

Locate well correctly on above
Section Plat

If a producing well is abandoned, date of last production _____ 19____
Was permission obtained from the Conservation Division or its agents before plugging was commenced? yes

Name of Conservation Agent who supervised plugging of this well Mr. Frank Broadfoot
Producing formation _____ Depth to top _____ Bottom _____ Total Depth of Well 4770 Feet
Show depth and thickness of all water, oil and gas formations.

OIL, GAS OR WATER RECORDS

CASING RECORD

FORMATION	CONTENT	FROM	TO	SIZE	PUT IN	PULLED OUT
		0	356	8 5/8"	356'	none

Describe in detail the manner in which the well was plugged, indicating where the mud fluid was placed and the method or methods used in introducing it into the hole. If cement or other plugs were used, state the character of same and depth placed, from _____ feet to _____ feet for each plug set.

Hole filled with mud	4770	-	300'
plug	300	-	296
20 sks cement	296	-	40
plug	40	-	36
10 sks cement	36	-	6 bottom of cellar

RECEIVED
STATE CORPORATION COMMISSION
JUL 15 1960
CONSERVATION DIVISION
Wichita, Kansas

Name of Plugging Contractor Sun Cementing Company
Address Great Bend, Kansas

STATE OF Kansas, COUNTY OF Sedgwick, ss.
John H. Knightley (employee of owner) or (not an owner) of the above-described well, being first duly sworn on oath, says: That I have knowledge of the facts statements, and matters herein contained and the log of the above-described well as filed and that the same are true and correct. So help me God.

(Signature) John H. Knightley
Wichita, Kansas (Address)

SUBSCRIBED AND SWORN TO before me this 8 day of July, 19 60
My commission expires Sept. 14, 1963
Elizabeth Kay Notary Public.

D. R. Lauck Oil Company, Inc.
 & National Cooperative Refinery Asso.

Palmitier #1

C SW SW Sec.16-25S-16W
 Edwards County Kansas

Commenced: June 13, 1960
 Completed: June 28, 1960

Casing Record: 356' 8 5/8" cemented with 225 sacks
 Calcium Chloride 4 "

Elevation: GR 2077; DF 2079; KB 2081.

Drillers Log

Tops

			Sample	WElex
Surface sand & clay	20	Heebner	3728-1647	3726-1645
sand	155	Toronto	3746-1665	3746-1665
Blue Shale	310	Douglas	3771-1690	3764-1683
red bed	320	Brown Lime	3868-1787	3868-k787
sand	332	Lansing	3878-1797	3876-1795
red bed	390	Base Kansas City	4167-2086	4162-2081
sand & red bed	585	Cherokee Sand	4329-2248	4330-2249
red bed	1065	Mississippian	4354-2273	4354-2273
sand	1085	Kinderhook shale	4401-2320	4401-2320
red bed & shale	1175	Kinderhook sand	4420-2339	4420-2339
red bed, shale & shells	1710	Viola	4466-2385	4468-2387
shale & shells	1820	Simpson shale		4648-2567
shale & lime	2045	Simpson Dolomite	4646-2565	4650-2569
Anhydrite & shale	2095	Arbuckle	4740-2660	
Lime & shale	2590			
shale & Lime	2815	Rotary Total Depth	4770-2689	4731-2650
shale & shells	2860			
shale & lime	3200			
lime & shale	3490	DST #1 (Miller)	4307-4355	open 1 hr; weak blow 3 min. and died; recov. 10 ft.drilling mud; ISIP 150# 30 min. FSIP 0# in 30 min.FPs 0-0
Lime (chalky) shale strks	3590			
Lime	3665			
Lime & shale	3725			
Lime	3732			
shale	3737			
Lime & shale	3760	DST #2 (Sun)	4369-4395	open 1 hr; fair blow throughout; recov. 120'gas; 70'gassy slightly oil cut mud; ISIP 745# 30 min.still bldg. FSIP 185# 30 min.still bldg. FPs 95#-110#.
Douglas	3870			
Lime	4245			
Chalky lime & shale	4295			
Lime & shale	4350			
sand	4355			
chert & shale	4395			
chert	4400			
chert, shale & sand	4445			
shale & chert	4470			
chert	4495			
Viola	4523			
chert, shale & lime	4591			
chert & cherty lime	4620			
chert, chalky lime, shale	4655			
shale, sand & Lime	4710			
Lime (Arbuckle)	4735			
shale & lime	4760			
Lime	4770	R. T. D.		

D & A.

RECEIVED
 STATE CORPORATION COMMISSION
 JUL 15 1960
 CONSERVATION DIVISION
 Wichita, Kansas