


Give All Information Completely
Make Required Affidavit
Mail or Deliver Report to:
Conservation Division
State Corporation Commission
800 Biting Building
Wichita, Kansas

Stafford County, Sec. 18 Twp. 25 Rge. 15 (E) (W)

Location as "NE/CNW&SW" or footage from lines NE NW NE
Lease Owner NATIONAL COOPERATIVE REFINERY ASSOCIATION
Lease Name Aiken Well No. 1
Office Address 820 Union National Bank Building, Wichita, Kansas.
Character of Well (completed as Oil, Gas or Dry Hole) Dry Hole.
Date well completed November 12, 1953
Application for plugging filed November 12, 1953
Application for plugging approved November 14, 1953
Plugging commenced November 12, 1953
Plugging completed November 12, 1953
Reason for abandonment of well or producing formation Dry Hole

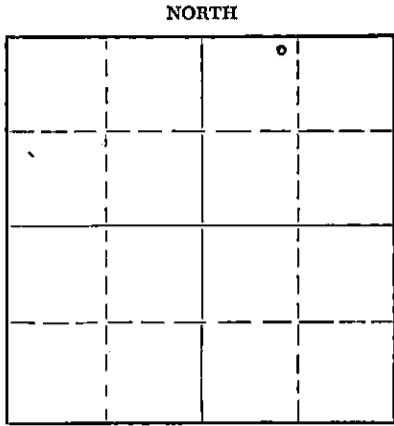

Locate well correctly on above Section Plat

If a producing well is abandoned, date of last production _____ 19____
Was permission obtained from the Conservation Division or its agents before plugging was commenced? Yes.

Name of Conservation Agent who supervised plugging of this well M. A. Rives
Producing formation _____ Depth to top _____ Bottom _____ Total Depth of Well 4654 Feet
Show depth and thickness of all water, oil and gas formations.

OIL, GAS OR WATER RECORDS

CASING RECORD

FORMATION	CONTENT	FROM	TO	SIZE	PUT IN	PULLED OUT
				8 5/8"	310'	Cemented

Describe in detail the manner in which the well was plugged, indicating where the mud fluid was placed and the method or methods used in introducing it into the hole. If cement or other plugs were used, state the character of same and depth placed, from _____ feet to _____ feet for each plug set.

Filled hole from 4654 to 300', set plug at 3008 with 1/2 sack hulls and 20 sacks cement. Filled on up to 40' with mud and set top plug at 40' with 10 sacks of cement. Filled on up to base of cellar.

11-24-53

CONSERVATION DIVISION
Wichita, Kansas

(If additional description is necessary, use BACK of this sheet)
Name of Plugging Contractor Musgrove Petroleum Corporation
Address 518 Petroleum Building, Wichita, Kansas

STATE OF Kansas, COUNTY OF Sedgwick, ss.
C. R. Sears (employee of owner) or (owner or operator) of the above-described well, being first duly sworn on oath, says: That I have knowledge of the facts, statements, and matters herein contained and the log of the above-described well as filed and that the same are true and correct. So help me God.

(Signature) C. R. Sears
820 Union National Bank Building, Wichita, Ks.
(Address)

SUBSCRIBED AND SWORN TO before me this 23 day of November, 19 53

My commission expires June 30, 1954

C. Orville May
C. Orville May
Notary Public.

PLUGGING
FILE SEC 18 T 25 R 15 W
BOOK PAGE 148 LINE 41

15-185-00119-0000

CONTRACTOR'S WELL LOG

COMPANY:	National CoOp. Refiners Ass'n.
CONTRACTOR:	Musgrove Petroleum Corporation
FARM:	Aiken #1
LOCATION:	C NE NW NE, Sec. 18-25-15 Stafford County, Kansas.
COMMENCED:	October 27, 1953
COMPLETED:	November 12, 1953

0	70	Surface sand and gravel
70	160	Sand and gravel
160	295	Shale & shell
295	310	Red bed
310	580	Red bed & shale
580	1110	Shale & sand
1110	1400	Blue shale
1400	1865	Shale & shells
1865	4258	Lime & shale
4258	4270	Shale, lime & Miss. chert
4270	4325	Lime & Miss. chert
4325	4360	Shale & chert
4360	4410	Lime & chert
4410	4523	Lime, shale & chert
4523	4557	Shale, lime, chert & hard sand
4557	4585	Lime, shale & chert
4585	4608	Shale & lime
4608	4654	Shale & Arbuckle
	4654	Rotary Total Depth

Set 8-5/8" surface casing at 310' with 250 sacks of cement

Dry and Abandoned.

STATE OF KANSAS)
) SS
COUNTY OF SEDGWICK)

I, GORDON E. KOELLING, do hereby certify that the above and foregoing is a true and correct copy of the log of the Aiken #1, C NE NW NE, Section 18-25-15, Stafford County, Kansas, as reflected by the files of the Musgrove Petroleum Corporation.

MUSGROVE PETROLEUM CORPORATION

BY Gordon E. Koelling
Secretary-treasurer

Subscribed and sworn to before me, a Notary Public, in and for Sedgwick County, Kansas, this 18th day of November, 1953.

Alvin E. Rouse
Notary Public

11-21-53

My commission expires July 16, 1955.

PLUGGING
 T1 SEC. 18 T 25 R 15W
 BOOK PAGE 142 LINE 41