


STATE OF KANSAS  
STATE CORPORATION COMMISSION

WELL PLUGGING RECORD

Give All Information Completely  
Make Required Affidavit  
Mail or Deliver Report to:  
Conservation Division  
State Corporation Commission  
211 No. Broadway  
Wichita, Kansas

Stafford County. Sec. 25 Twp. 25S Rge. 15 (W)

Location as "NE/CNW/SW" or footage from lines C NW NW  
Lease Owner Nadel & Gussman  
Lease Name Stambaugh "A" Well No. 1  
Office Address 1714 First National Bank Building, Tulsa 3, Oklahoma  
Character of Well (completed as Oil, Gas or Dry Hole) Dry Hole  
Date well completed March 19 19 64  
Application for plugging filed March 19 19 64  
Application for plugging approved March 19 19 64  
Plugging commenced March 19 19 64  
Plugging completed March 19 19 64  
Reason for abandonment of well or producing formation Dry Hole

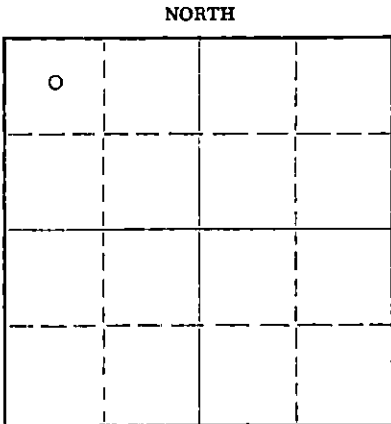

Locate well correctly on above Section Plat

If a producing well is abandoned, date of last production -- 19 --  
Was permission obtained from the Conservation Division or its agents before plugging was commenced? Yes

Name of Conservation Agent who supervised plugging of this well Archie Elving, St. John, Kansas  
Producing formation -- Depth to top -- Bottom -- Total Depth of Well -- Feet  
Show depth and thickness of all water, oil and gas formations.

OIL, GAS OR WATER RECORDS

CASING RECORD

FORMATION	CONTENT	FROM	TO	SIZE	PUT IN	PULLED OUT
		0	264	8-5/8	264	---

Describe in detail the manner in which the well was plugged, indicating where the mud fluid was placed and the method or methods used in introducing it into the hole. If cement or other plugs were used, state the character of same and depth placed, from -- feet to -- feet for each plug set.

Filled hole to 250' with rotary mud. Pushed plug and hulls to fluid with drill pipe. Cemented with 25 sacks cement through drill pipe. Filled hole to 40' with rotary mud. Pushed plug and hulls to fluid. Cemented with 10 sacks cement. Two sacks in rate hole. Job completed at 11:00 A. M. 3/19/64

RECEIVED  
STATE CORPORATION COMMISSION

APR 21 1964

4-21-64

CONSERVATION DIVISION  
Wichita, Kansas

(If additional description is necessary, use BACK of this sheet)  
Name of Plugging Contractor Western Petroleum Co., Inc.  
Address P. O. Box 524, Great Bend, Kansas

STATE OF Kansas, COUNTY OF Barton, ss.  
F. L. Copeland (employee of owner) or ~~(owner or operator)~~ of the above-described

well, being first duly sworn on oath, says: That I have knowledge of the facts, statements, and matters herein contained and the log of the above-described well as filed and that the same are true and correct. So help me God.

(Signature) F. L. Copeland

F. L. Copeland, P. O. Box 524, Great Bend, Ks.  
(Address)

SUBSCRIBED AND SWORN TO before me this 17th day of April, 19 64

My commission expires January 15, 1967

Reva C. Brown  
Reva C. Brown

Notary Public.

15-185-11851-0000

DRILLER'S LOG  
STAMBAUGH "A" #1

COMPANY: NADEL & GUSSMAN WESTERN PETROLEUM Co., INC. ELEVATION: 2001' DF 2003' KB  
 CONTRACTOR: WESTERN PETROLEUM Co., INC. CASING RECORD: 12 JTS. 8-5/8" 28# PIPE.  
 COMMENCED: MARCH 7, 1964 TOTAL DEPTH: 4396'  
 COMPLETED: MARCH 19, 1964  
 DESCRIPTION: NW, NW SECTION 25-T25S-R15W STAFFORD COUNTY, KANSAS

FORMATION	FROM	TO	REMARKS
SAND	0	40	DST #1, 3953-3975'. OPEN 30 MINUTES.
SAND GRAVEL	40	230	WEAK BLOW FOR 8". RECOVERED 12' MUD,
BLUE SHALE	230	265	FEW SPECKS OF OIL. 1BHP 255#/30", FBHP
RED BED	265	380	30#/30", FPO#.
SHALE, SHELL, RED BED	380	960	
ANHYDRITE	960	975	DST #2, 4242-4270'. OPEN ONE HOUR. WEAK
SHALE, LIME, SHELLS	975	1120	BLOW FOR 41". RECOVERED 25' MUD. ISIP
SHALE, SHELLS, LIME	1120	1661	25#/30", FSIP 30#/30", IFP 0#, FFP 15#.
SHALE & LIME	1661	1975	
LIME & SHALE	1975	2696	DST #3, 4270-4285'. OPEN ONE HOUR. WEAK
SHALE & LIME	2696	2928	STEADY BLOW FOR 32". RECOVERED 62' MUD.
LIME & SHALE	2928	3645	ISIP 1330#/30", FSIP 780#/30", IFP 0#,
LIME	3645	3745	FFP 20#.
SHALE & LIME	3745	3848	
LIME	3848	4176	DST #4, 4317-4326'. OPEN ONE HOUR.
SHALE & LIME	4176	4218	WEAK BLOW FOR 32". FLUSHED THE TOOL,
LIME, SHALE	4218	4270	WEAK BLOW FOR 4". RECOVERED 22' THIN
CHERT	4270	4285	MUD. 1BHP 135#/45", FSIP 120#/45", FP 0#.
CHERT & SHALE	4285	4326	
CHERT, LIME, SHALE	4326	4367	
CHERT, SHALE, LIME	4367	4396	

ELECTRIC LOG TOPS

ANHYDRITE	964	41039
HEEBNER	3657	-1654
LANSING	3826	-1823
B/KC	4104	-2101
MISS. 'A'	4263	-2260
MISS. 'B'	4318	-2315
KINDERHOOK	4332	-2329
VIOLA	4385	-2382

RECEIVED  
STATE CORPORATION COMMISSION

MAR 23 1964  
3-23-64  
CONSERVATION DIVISION  
Wichita, Kansas

STATE OF KANSAS }  
COUNTY OF BARTON } SS

I, THE UNDERSIGNED, BEING DULY SWORN ON OATH, STATE THAT THE ABOVE STATEMENT AND LOG ARE TRUE AND A CORRECT RECORD AND LOG OF THE WELL DRILLED AT THE LOCATION ABOVE DESCRIBED.

WESTERN PETROLEUM CO., INC.

*F. L. Copeland*  
F. L. COPELAND, DRILLING SUPT.

SUBSCRIBED AND SWORN TO BEFORE ME THIS 21ST DAY OF MARCH, 1964.

*Elaine F. Bentley*  
ELAINE F. BENTLEY

MY COMMISSION EXPIRES 2/11/68.