


STATE OF KANSAS
STATE CORPORATION COMMISSION

WELL PLUGGING RECORD

Give All Information Completely
Make Required Affidavit
Mail or Deliver Report to
Conservation Division
State Corporation Comm.
245 North Water
Wichita, KS 67202

Stafford County. Sec. 30 Twp. 25S Rge. 15W /^{7W}
Location as "NE/CNW $\frac{1}{4}$ SW $\frac{1}{4}$ " or footage from lines CE/2 SW SW

Lease Owner D. R. Lauck Oil Company, Inc.
Lease Name Lamb "A" Well No. 1
Office Address 221 S. Broadway, Wichita, Kansas 67202
Character of Well (Completed as Oil, Gas or Dry Hole) Dry Hole

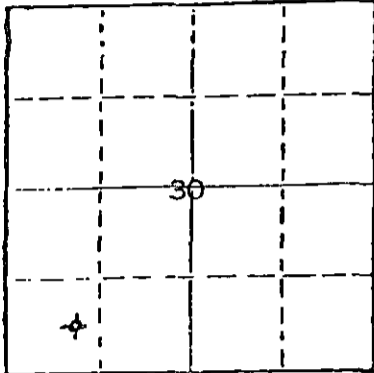

Locate well correctly on above
Section Plot

Date Well completed August 17, 1979
Application for plugging filed August 17, 1979
Application for plugging approved August 17, 1979
Plugging commenced August 17, 1979
Plugging completed August 17, 1979
Reason for abandonment of well or producing formation Dry Hole

If a producing well is abandoned, date of last production 19

Was permission obtained from the Conservation Division or its agents before plugging was commenced? Yes

Name of Conservation Agent who supervised plugging of this well Wm. T. Owen
Producing formation _____ Depth to top _____ Bottom _____ Total Depth of Well 4390'
Show depth and thickness of all water, oil and gas formations.

OIL, GAS OR WATER RECORDS

CASING RECORD

FORMATION	CONTENT	FROM	TO	SIZE	PUT IN	PULLED OUT
		0'	379'	8-5/8"	372.95'	None

Describe in detail the manner in which the well was plugged, indicating where the mud fluid was placed and the method or methods used in introducing it into the hold. If cement or other plugs were used, state the character of same and depth placed, from _____ feet to _____ feet for each plug set.

Plugged with 40 sacks cement at 360',
bridge plug and 12 sacks cement at 40',
and 3 sacks cement in rat hole.

8-30-79
RECEIVED
STATE CORPORATION COMMISSION
AUG 30 1979
CONSERVATION DIVISION
Wichita, Kansas

(If additional description is necessary, use BACK of this sheet)
Name of Plugging Contractor Allied Cementing Company

STATE OF KANSAS COUNTY OF SEDGWICK, ss.
John D. Knightley (employee of owner) or (owner or operator)
of the above-described well, being first duly sworn on oath, says: That I have knowledge of the facts, statements, and matters herein contained and the log of the above-described well as filed and that the same are true and correct. So help me God.

(Signature) [Signature]
221 S. Broadway, Wichita, Kansas
(Address)

SUBSCRIBED AND SWORN TO before me this 24th day of August, 19 79



My commission expires March 12, 1983

[Signature]
Notary Public.

15-185-20944-0000

D. R. Lauck Oil Company, Inc. - Lamb "A" #1
221 S. Broadway, Suite 400 C E/2 SW SW Sec. 30-25S-15W
Wichita, Kansas 67202 Stafford County, Kansas

Contractor: D. R. Lauck Oil Company, Inc.
221 S. Broadway, Suite 400
Wichita, Kansas 67202

Commenced: August 10, 1979
Completed: August 17, 1979

Drillers Log

Red Bed	435
Red Bed & Shale	995
Anhydrite	1050
Shale	2048
Shale & Shells	2315
Shale	2565
Shale & Shells	3320
Shale	3332
Shale & Lime	3395
Shale & Shells	3640
Lime	4390 RTD

RECEIVED
STATE CORPORATION COMMISSION

AUG 30 1979

CONSERVATION DIVISION
Wichita, Kansas