


STATE OF KANSAS
STATE CORPORATION COMMISSION

Form CP-4

Give All Information Completely
Make Required Affidavit
Mail or Deliver Report to:
Conservation Division
State Corporation Commission
212 No. Market
Wichita, Kansas

WELL PLUGGING RECORD

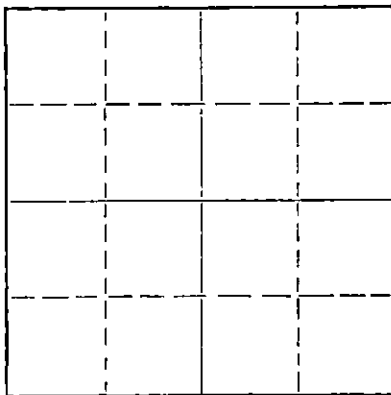

Locate well correctly on above
Section Plat

STAFFORD County. Sec. 30 Twp. 25S Rge. 15W (E) (W)
Location as "NE/CNW*SW*" or footage from lines C SE SW
Lease Owner SANTA-FE PIPE & SUPPLY, INC
Lease Name LAMB Well No. 2
Office Address BOX 562, GREAT BEND, KANSAS
Character of Well (completed as Oil, Gas or Dry Hole) OIL WELL
Date well completed DECEMBER 10 1960
Application for plugging filed NOVEMBER 3 1965
Application for plugging approved NOVEMBER 4 1965
Plugging commenced November 3 1965
Plugging completed JUNE 27 1966
Reason for abandonment of well or producing formation DEPLETED

If a producing well is abandoned, date of last production _____ 19____
Was permission obtained from the Conservation Division or its agents before plugging was commenced? YES

Name of Conservation Agent who supervised plugging of this well ARCHIE ELVING
Producing formation _____ Depth to top _____ Bottom _____ Total Depth of Well 4372 Feet
Show depth and thickness of all water, oil and gas formations.

OIL, GAS OR WATER RECORDS

CASING RECORD

FORMATION	CONTENT	FROM	TO	SIZE	PUT IN	PULLED OUT
				8 5/8"	411	NONE
				5 1/2"	4370'	3304

Describe in detail the manner in which the well was plugged, indicating where the mud fluid was placed and the method or methods used in introducing it into the hole. If cement or other plugs were used, state the character of same and depth placed, from _____ feet to _____ feet for each plug set.

4370' - 4250' - PLUG
4250' - 4225' - SAND
4225' - 4160' - SAND
4160' - 4120' - 5 SACKS CEMENT
4120' - 325' - MUD
325' - 315' - ROCK BRIDGE
315' - 300' - 5 SACKS CEMENT
300' - 240' - 20 SACKS CEMENT
240' - 40' - MUD
40' - 30' - ROCK BRIDGE
30' - BASE - 10 SACKS CEMENT

STATE CORPORATION COMMISSION
JUL 29 1966
7-29-66
CONSERVATION DIVISION
Wichita, Kansas

(If additional description is necessary, use BACK of this sheet)
Name of Plugging Contractor SANTA-FE PIPE & SUPPLY, INC
Address BOX 562, GREAT BEND, KANSAS

STATE OF KANSAS COUNTY OF BARTON, ss.
T.L. NUTT (employee of owner) or (owner or operator) of the above-described

well, being first duly sworn on oath, says: That I have knowledge of the facts, statements, and matters herein contained and the log of the above-described well as filed and that the same are true and correct. So help me God.

(Signature) T.L. Nutt

BOX 562, GREAT BEND, KANSAS
(Address)

Subscribed and Sworn to before me this 28th day of JULY 1966

My commission expires JULY 31, 1966
Mary M. Swanson Notary Public.

15-125-01578-0000

WELL LOG BUREAU—KANSAS GEOLOGICAL SOCIETY
508 East Murdock, Wichita, Kansas


COPY

Company- R. H. SIEGFRIED, INC.
Farm- Lamb No. 2

SEC. 30 T. 25 R.15W
C SE SW

Total Depth. 4372'
Comm. 11-28-60 Comp. 12-10-60
Shot or Treated.
Contractor. Chief Drig. Co.
Issued. 7-22-61

County Stafford
KANSAS

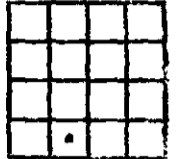

Elevation. 2040' DF

Production. 24 BOPD &
750,000 CFG

Figures Indicate Bottom of Formations.

sand & shale	210
clay & shale	409
shale & redbed	590
sand & redbed	800
shale & shells	980
shale	993
Anhydrite	1008
shale & lime	2100
lime & shale	2790
shale w/lime strks	3160
lime & shale	3400
lime	3679
shale & lime	3839
lime	4180
lime & shale	4261
shale w/sand	4330
chert & lime	4372
Total Depth	

TOPS:	
Anhydrite (drillers)	993
Heebnar	3679
Toronto	3696
Douglas	3715
Brown Lime	3825
Lansing	3839
Cherokee Shale	4261
Cherokee Sand	4274
Viola	4330

RECEIVED
STATE CORPORATION COMMISSION
JUL 29 1966
CONSERVATION DIVISION
Wichita, Kansas