

STATE OF KANSAS
STATE CORPORATION COMMISSION

Give All Information Completely
Make Required Affidavit
Mail or Deliver Report to:
Conservation Division
State Corporation Commission
800 Bittling Building
Wichita, Kansas

OR


FORMATION PLUGGING RECORD

Strike out upper line
when reporting plug-
ging off formations.

Stafford County. Sec 33 Twp 25S Rge (E) 15 (W)

Location as "NE $\frac{1}{4}$ NW $\frac{1}{4}$ SW $\frac{1}{4}$ " or footage from lines SW $\frac{1}{4}$ SW $\frac{1}{4}$ NE $\frac{1}{4}$
Lease Owner Alpine Oil & Royalty Co., Inc., et al
Lease Name Stambaugh Well No. 1
Office Address Bittling Building, Wichita, Kansas
Character of Well (completed as Oil, Gas or Dry Hole) Dry Hole
Date well completed May 23, 1948
Application for plugging filed May 23, 1948
Application for plugging approved May 23, 1948
Plugging commenced May 24, 1948
Plugging completed May 24, 1948
Reason for abandonment of well or producing formation Dry Hole

NORTH

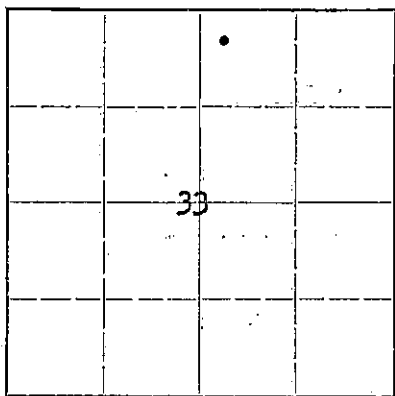

Locate well correctly on above
Section Plat

If a producing well is abandoned, date of last production 19
Was permission obtained from the Conservation Division or its agents before plugging was com-
menced? Yes

Name of Conservation Agent who supervised plugging of this well C. D. Stough
Producing formation Depth to top Bottom Total Depth of Well 4622 Feet
Show depth and thickness of all water, oil and gas formations.

OIL, GAS OR WATER RECORDS


CASING RECORD

Formation	Content	From	To	Size	Put In	Pulled Out
				8-5/8"	295'	

Describe in detail the manner in which the well was plugged, indicating where the mud fluid was placed and the method or methods used in introducing it into the hold. If cement or other plugs were used, state the character of same and depth placed, from feet to feet for each plug set.

Hole filled with heavy mud to 290 feet, then 15 sacks cement at 290 feet through drill pipe, then hole filled with heavy mud to within 25 feet of bottom of cellar. 10 sacks cement at top of surface.

6-2-48

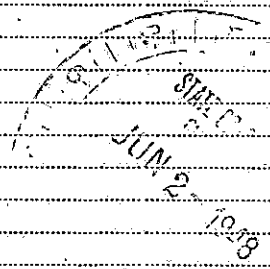

(If additional description is necessary, use BACK of this sheet)

Correspondence regarding this well should be addressed to Alpine Oil & Royalty Co., Inc.
Address Bittling Building, Wichita 2, Kansas.

STATE OF Kansas, COUNTY OF Rice, SS.
Rollin Mead (employee of owner) or (owner or operator) of the above-described well,
being first duly sworn on oath, says: That I have knowledge of the facts, statements, and matters herein contained and the log of the above-described well as filed and that the same are true and correct. So help me God.

(Signature) Rollin Mead
Sterling, Kansas (Address)

SUBSCRIBED AND SWORN to before me this 26th day of May, 1948
J. H. Urell
Notary Public.

My commission expires September 17, 1949.

15-185-01224-0000

WELL LOG

STAMBAUGH NO. 1

Location - - SW $\frac{1}{4}$ SW $\frac{1}{4}$ NE $\frac{1}{4}$ of Section 33-25S-15W, Stafford County, Kansas

Owner - - - - Alpine Oil & Royalty Co., Inc., et al.
Contractor - Sterling Drilling Company

Commenced - - April 30, 1948
Completed - - May 24, 1948 (plugged)

Total Depth - 4622'

LOG

0- 240 Sand & Clay
 240- 325 Shale & Shells
 325- 725 Sand & Red Bed
 725-1010 Red Bed
 1010-1040 Anhydrite
 1040-1125 Red Bed
 1125-1350 Red Bed and Sand
 1350-1535 Shale & Shells
 1535-1720 Salt & Shale
 1720-1900 Shale & Shells
 1900-1925 Lime - Fort Riley
 1925-2095 Lime
 2095-2140 Lime & Shale
 2140-2180 Lime
 2180-2845 Lime & Shale
 2845-3260 Shale
 3260-3330 Shale & Lime
 3330-3350 Shale
 3350-3395 Lime - Topeka
 3395-3496 Lime
 3496-3581 Lime - Soft
 3581-3728 Lime
 3728-3785 Lime & Shale
 3785-3839 Shale
 3839-3845 K. C. Lime
 3845-4365 Lime
 4365-4430 Lime & Chert
 4430-4473 Lime
 4473-4486 Lime & Chert
 4486-4509 Shale & Chert Streaks
 4509-4517 Lime
 4517-4532 Shale
 4532-4570 Shale & Sand (Simpson)
 4570-4588 Shale
 4588-4615 Lime - Arbuckle
 4615-4622 Lime

CASING RECORD

295' 8-5/8" Surface Pipe
Cemented with 250 Sacks Cement

FORMATION TOPS - Elevation 2031 - (RB)

Heebner	3684	(-1653)
Brown Lime	3817	(-1786)
Lansing	3836	(-1805)
Miss.	4349	(-2318)
Viola	4402	(-2371)
Simpson Sh.	4531	(-2500)
Arb.	4588	(-2557)
Total Depth	4622	

PRODUCTION

None Dry.

6-2-48

I hereby certify that the above is a true and correct copy of Driller's Log of well drilled in the SW $\frac{1}{4}$ SW $\frac{1}{4}$ NE $\frac{1}{4}$ of Section 33-25S-15W, Stafford County, Kansas.

STERLING DRILLING COMPANY

By H. C. Sullivan
President

Subscribed and sworn to before me this 26th day of May, 1948.

J. C. Mueller
Notary Public

My term expires September 17, 1949.

15-185-01224-0000

WELL LOG

STAMBAUGH NO. 1

Location -- SW 1/4 SW 1/4 NE 1/4 of Section 33-25S-15W, Stafford County, Kansas

Owner --- -- Alpine Oil & Royalty Co., Inc., et al

Contractor -- Sterling Drilling Company

Commenced -- April 30, 1948

Completed -- May 24, 1948 (plugged)

Total Depth - 4622'

LOG

CASING RECORD

0- 240 Sand & Clay
 240- 325 Shale & Shells
 325- 725 Sand & Red Bed
 725-1010 Red Bed
 1010-1040 Anhydrite
 1040-1125 Red Bed
 1125-1350 Red Bed and Sand
 1350-1535 Shale & Shells
 1535-1720 Salt & Shale
 1720-1900 Shale & Shells
 1900-1925 Lime - Fort Riley
 1925-2095 Lime
 2095-2140 Lime & Shale
 2140-2180 Lime
 2180-2845 Lime & Shale
 2845-3260 Shale
 3260-3330 Shale & Lime
 3330-3350 Shale
 3350-3395 Lime - Topeka
 3395-3496 Lime
 3496-3541 Lime - Soft
 3541-3728 Lime
 3728-3785 Lime & Shale
 3785-3839 Shale
 3839-3845 K. C. Lime
 3845-4365 Lime
 4365-4430 Lime & Chert
 4430-4473 Lime
 4473-4486 Lime & Chert
 4486-4509 Shale & Chert Streaks
 4509-4517 Lime
 4517-4532 Shale
 4532-4570 Shale & Sand (Simpson)
 4570-4588 Shale
 4588-4615 Lime - Arbuckle
 4615-4622 Lime

295' 8-5/8" Surface Pipe
Cemented with 250 Sacks Cement

FORMATION TOPS -- Elevation 2031 (RB)

Keebner	3684	(-1653)
Brown Lime	3917	(-1786)
Lansing	3836	(-1805)
Hills.	4349	(-2318)
Viola	4402	(-2371)
Simpson Sh.	4531	(-2500)
Arb.	4588	(-2557)
Total Depth	4622	

PRODUCTION

None Dry.

5-29-48

MAY 29 1948

I hereby certify that the above is a true and correct copy of Driller's Log of well drilled in the SW 1/4 SE 1/4 NE 1/4 of Section 33-25S-15W, Stafford County, Kansas.

STERLING DRILLING COMPANY

By J. E. [Signature]
President

Subscribed and sworn to before me this 26th day of May, 1948.

J. H. [Signature]
Notary Public

My term expires September 17, 1949.

PLUGGING
 FILE SEC 33-25-15W
 BOOK PAGE 31 LINE 38