

STATE OF KANSAS
STATE CORPORATION COMMISSION

15-185-01156-0000
WELL PLUGGING RECORD

Give All Information Completely
Make Required Affidavit
Mail or Deliver Report to:
Conservation Division
State Corporation Commission
212 North Market, Insurance Bldg.
Wichita, Kansas

Stafford County, Sec. 34 Twp. 25 Rge. 15 ~~NE~~X (W)

Location as "NE/CNW/SW" or footage from lines C NE SE

Lease Owner D.R. Lauck Oil Company, Inc.

Lease Name Kennedy Well No. 1

Office Address 301 So. Broadway Wichita 2 Kansas

Character of Well (completed as Oil, Gas or Dry Hole) dry hole

Date well completed August 9 19 60

Application for plugging filed " 9 19 60

Application for plugging approved " 9 19 60


Plugging commenced " 9 19 60

Plugging completed " 9 19 60

Reason for abandonment of well or producing formation dry hole

If a producing well is abandoned, date of last production -- 19 --

Was permission obtained from the Conservation Division or its agents before plugging was commenced? yes

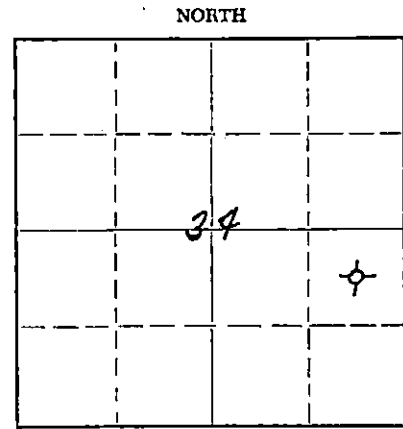

Locate well correctly on above Section Plat

Name of Conservation Agent who supervised plugging of this well Mr. Frank Broadfoot

Producing formation _____ Depth to top _____ Bottom _____ Total Depth of Well 4610 Feet

Show depth and thickness of all water, oil and gas formations.

OIL, GAS OR WATER RECORDS

CASING RECORD

FORMATION	CONTENT	FROM	TO	SIZE	PUT IN	PULLED OUT
		0	279	8 5/8"	279	none

Describe in detail the manner in which the well was plugged, indicating where the mud fluid was placed and the method or methods used in introducing it into the hole. If cement or other plugs were used, state the character of same and depth placed, from _____ feet to _____ feet for each plug set.

hole filled with mud 4610 - 240
 plug 240 - 236
 20 sax cement 236 - 196
 mud 196 - 35
 plug 35 - 31
 cement 31 - 6 bottom of cellar

8-16-60

RECEIVED
STATE CORPORATION COMMISSION

AUG 16 1960

CONSERVATION DIVISION
Wichita, Kansas.

(If additional description is necessary, use BACK of this sheet)
 Name of Plugging Contractor Halliburton Cementing Company
 Address Great Bend, Kansas

STATE OF Kansas COUNTY OF Sedgwick, ss.
John H. Knightley (employee of owner) or (owner or operator) of the above-described well, being first duly sworn on oath, says: That I have knowledge of the facts, statements, and matters herein contained and the log of the above-described well as filed and that the same are true and correct. So help me God.

(Signature) John H. Knightley
Wichita, Kansas
 (Address)

SUBSCRIBED AND SWORN TO before me this 15 day of August, 19 60

My commission expires Sept. 14, 1963

Elizabeth Ray
 Notary Public.



15-185-01156-0000

D. R. Lauck Oil Company, Inc.

Kennedy #1

C NE SE Sec.34-25S-15W
Stafford County, Kansas

Commenced: July 27, 1960
Completed: Aug. 9, 1960

Casing Record: 279 ft. 8 5/8" cemented with 225 sacks
Calcium Chloride 4 sacks

Elevation: GR 2021; DF 2024; KB 2026

Drillers Log

Tops

			Sample	Schlumberger
Sand	230	Heebner	3688-1662	3689-1663
shale	300	Brown Lime	3829-1803	3828-1802
Red Bed	480	Lansing	3849-1823	3847-1821
sand & Red Bed	600	Base Kansas City	4146-2120	4148-2122
Red Bed	975	Mississippian	4302-2276	4302-2276
Anhydrite	995	Kinderhook	4330-2304	4326-2300
shale & shells	1690	Viola	4440-2414	4439-2413
Anhydrite & shale	1940	Simpson	4530-2504	4527-2501
Anhydrite	2050	Arbuckle	4581-2555	4572-2546
Lime & shale	2395	Rotary Total Depth	4610-2584	4610-2584
Broken lime	2450			
shale & Lime	2765			
shale & shells	3125	DST #1 (H)	4303-4315	open 30 min;
shale & lime	3315			weak blow 30 min. Recov.
Lime & shale	3425			5' mud; IFP 15# FFP 15#
Lime	3475			BHP 35# 20 min.
Lime & shale	3705			
shale-Lime streaks	3810			
shale	3895			
Lime	4154			D & A
shale & Lime	4175			
Lime & shale	4301			
chert	4355			
shale & chert	4440			
chert- shale & Lime	4475			
Viola	4535			
shale	4581			
lime	4610	R.T.D.		

8-16-60

RECEIVED
STATE CORPORATION COMMISSION

AUG 16 1960

CONSERVATION DIVISION
Wichita, Kansas