

15-185-20646-0000

STATE OF KANSAS  
STATE CORPORATION COMMISSION  
CONSERVATION DIVISION  
P. O. BOX 17027  
WICHITA, KANSAS 67217

FORM CP-4

WELL PLUGGING RECORD

Stafford County, Sec. 24 Twp. 25 Rge. 15 (E) (W)

Location as "NE/CNW&SW" or footage from lines. C SE SW  
Lease Owner National Development Co.

Lease Name Stambaugh Well No. 1  
Office Address 1300 Union National Building, Wichita, Ks. 67202

Character of Well (completed as Oil, Gas or Dry Hole) Dry Hole

Date well completed April 5 19 76

Application for plugging filed April 5 19 76

Application for plugging approved April 5 19 76


Plugging commenced April 5 19 76

Plugging completed April 5 19 76

Reason for abandonment of well or producing formation Dry Hole

If a producing well is abandoned, date of last production 19

Was permission obtained from the Conservation Division or its agents before plugging was commenced? yes

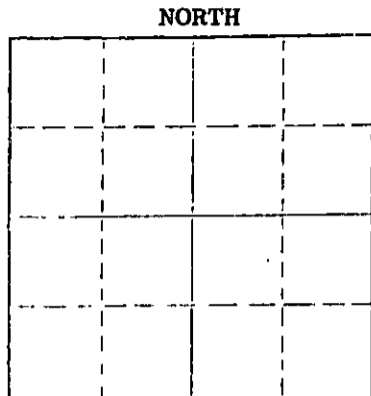

Locate well correctly on above Section Plat

Name of Conservation Agent who supervised plugging of this well G. R. Biberstein

Producing formation Depth to top Bottom Total Depth of Well 4334 Feet

Show depth and thickness of all water, oil and gas formations.

OIL, GAS OR WATER RECORDS

CASING RECORD

FORMATION	CONTENT	FROM	TO	SIZE	PUT IN	PULLED OUT

Describe in detail the manner in which the well was plugged, indicating where the mud fluid was placed and the method or methods used in introducing it into the hole. If cement or other plugs were used, state the character of same and depth placed, from feet to feet for each plug set.

Hole full of heavy mud to 250' w/35 sacks cement.  
Top plug @ 40' w/1/2 sack hulls plug & 15 sacks cement.  
2 sacks cement in rat hole.

RECEIVED  
STATE CORPORATION COMMISSION  
APR 09 1976  
4-7-76  
CONSERVATION DIVISION  
WICHITA, KANSAS

Name of Plugging Contractor Duke Drilling Co.  
Address Box 823, Great Bend, Ks.

STATE OF KANSAS COUNTY OF BARTON  
Larry Curtis (employee of owner) or (XXXXXXXXXX) of the above-described

well, being first duly sworn on oath, says: That I have knowledge of the facts, statements, and matters herein contained and the log of the above-described well as filed and that the same are true and correct. So help me God.

(Signature) Larry Curtis  
Box 823, Great Bend, Ks.  
(Address)

SUBSCRIBED AND SWORN TO before me this 6th day of April 1976

My commission expires April 11, 1978  
Dorothy M. Hague  
Notary Public.

DRILLERS' WELL LOG

15-185-20646-0000

DATE COMMENCED: March 30, 1976  
DATE COMPLETED: April 5, 1976

National Development Co.  
STAMBAUGH # 1  
C SE SW of Sec 24-T25-R15W  
Stafford County, Kansas

ELEVATION: 1999 K.B.

0 - 220'	Sand
220 - 918'	Red Bed
918 - 934'	Anhydrite
934 - 1490'	Shale
1490 - 3220'	Shale and Lime
3220 - 3650'	Lime and Shale
3650 - 3654'	Shale
3654 - 4275'	Lime and Shale
4275 - 4334'	Chert and Lime
4334'	RTD

FORMATION TOPS

Anhydrite	918
Topeka	3220
Heebner	3650
Brown Lime	3798
Lansing	3824
Mississippi	4275
RTD	4334

SURFACE PIPE:

Set 264' of used 8 5/8",  
28# pipe w/225 sacks Common,  
2% Gel, 3% cc.

AFFIDAVIT

APR 07 1976

4-7-76

Notary Public  
Wichita, Kansas

STATE OF KANSAS }  
COUNTY OF BARTON } ss.

Larry Curtis, of lawful age, does swear and state that the facts and statements herein contained are true and correct to the best of his knowledge.

Larry Curtis

Subscribed and sworn to before me this 6th day of April, 1976.

Donald M. Hague  
Notary Public

My Commission Expires: April 11, 1978