


STATE OF KANSAS
STATE CORPORATION COMMISSION

15-185-20754-0000

WELL PLUGGING RECORD

Give All Information Completely
Make Required Affidavit
Mail or Deliver Report to
Conservation Division
State Corporation Comm.
245 North Water
Wichita, KS 67202

Stafford County. Sec. 24 Twp. 25 Rge. 15W E/W
Location as "NE/CNW $\frac{1}{4}$ SW $\frac{1}{4}$ " or footage from lines
C N $\frac{1}{2}$ NE
Lease Owner North American Drlg. & Exp.
Lease Name Wilson Well No. 1
Office Address 3420 W. Tenth Great Bend Kansas
Character of Well (Completed as Oil, Gas or Dry Hole)

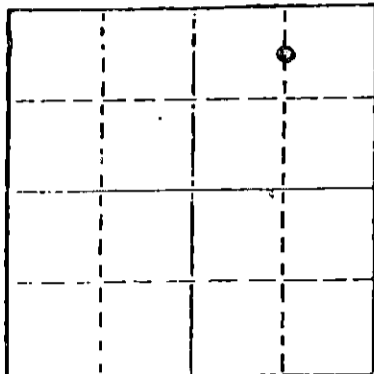

Locate well correctly on above
Section Plat

Gas
Date Well completed 5/ 1978
Application for plugging filed 12/1/78 1978
Application for plugging approved 12/3/ 1978
Plugging commenced 12/15 1978
Plugging completed 12/21 1978
Reason for abandonment of well or producing formation

Dry
If a producing well is abandoned, date of last production
9/ 1978

Was permission obtained from the Conservation Division or
its agents before plugging was commenced? Yes

Name of Conservation Agent who supervised plugging of this well Wm. T. Owen
Producing formation Miss Depth to top Bottom Total Depth of Well 4250
Show depth and thickness of all water, oil and gas formations.

OIL, GAS OR WATER RECORDS

CASING RECORD

FORMATION	CONTENT	FROM	TO	SIZE	PUT IN	PULLED OUT
	Surface	0	320	8 5/8		
		0	4249	5 1/2		2208

Describe in detail the manner in which the well was plugged, indicating where the mud fluid
was placed and the method or methods used in introducing it into the hold. If cement or other
plugs were used, state the character of same and depth placed, from _____ feet to
_____ feet for each plug set.

Fill hole with sand to 4150' and dump 4 sx. cement

Pumped top with Sun cementers 5 sx. hulls, 20 sxJell & 100 sx
60-40 Poz. 2% jell & 3% CC

12-26-78

RECEIVED
STATE CORPORATION COMMISSION

(If additional description is necessary, use BACK of this sheet)
Name of Plugging Contractor Nicholas Casing Pulling
Box 373 Geneseo Kansas 67444

CONSERVATION DIVISION
Wichita, Kansas

STATE OF Kansas COUNTY OF Rice, ss.
George A. Nicholas (employee of owner) or (owner or operator)
of the above-described well, being first duly sworn on oath, says: That I have knowledge of
the facts, statements, and matters herein contained and the log of the above-described well
as filed and that the same are true and correct. So help me God.

(Signature) George A. Nicholas
(Address)

SUBSCRIBED AND SWORN TO before me this 22nd day of December, 19 78



Jalane White
Notary Public.

My commission expires 8-22-82