


15-057-20007-0000

STATE OF KANSAS  
STATE CORPORATION COMMISSION

WELL PLUGGING RECORD

Give All Information Completely  
Make Required Affidavit  
Mail or Deliver Report to  
Conservation Division  
State Corporation Comm.  
245 North Water  
Wichita, KS 67202

Ford County, Sec. 22 Twp. 26S Rge. 24 NW  
Location as "NE/CNW $\frac{1}{2}$ SW $\frac{1}{2}$ " or footage from lines  
Near southwest corner of northeast quarter of above section.  
Lease Owner Farmland Industries, Inc.  
Lease Name Former Conrardy Farm Well No. 1  
Office Address P.O. Box 1337, Dodge City, Kansas 67801  
Character of Well (Completed as Oil, Gas or Dry Hole)  
Plant Effluent Disposal  
Date Well completed April 1968  
Application for plugging filed September 2 1976  
Application for plugging approved September 3 1976  
Plugging commenced September 15 1976  
Plugging completed September 15 1976  
Reason for abandonment of well or producing formation  
Plugged - Will no longer accept effluent.  
If a producing well is abandoned, date of last production 19

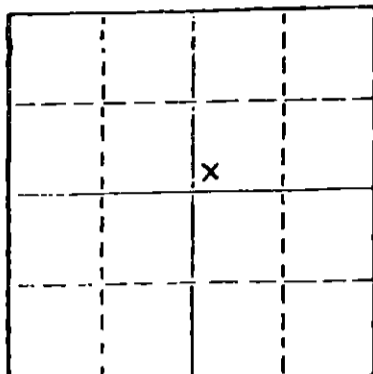

Locate well correctly on above  
Section Plat

Name of Conservation Agent who supervised plugging of this well Clarence Thomas  
Producing formation None Depth to top Bottom Total Depth of Well  
Show depth and thickness of all water, oil and gas formations.

OIL, GAS OR WATER RECORDS

REGULATED

CASING RECORD

FORMATION	CONTENT	FROM	TO	SIZE	PUT IN	PULLED OUT
Disposal			0	22 1/2"	10-22-76	

Describe in detail the manner in which the well was plugged, indicating where the mud fluid was placed and the method or methods used in introducing it into the hold. If cement or other plugs were used, state the character of same and depth placed, from \_\_\_\_\_ feet to \_\_\_\_\_ feet for each plug set.

The shaft was caved in and plugged at the 502 foot level below ground. Halliburton brought in their mix and pump trucks and mixed 50 sacks of Class A regular Portland cement and pumped it into the hole. Remainder to 40' level was filled with water and 6 sacks of Halliburton gel. From 40 foot level to surface mixed 15 sacks of Class A regular Portland cement and pumped and filled to the surface.

(If additional description is necessary, use BACK of this sheet)

Name of Plugging Contractor Halliburton

STATE OF Kansas COUNTY OF Ford, ss.  
J. P. Winterhalter (employee of owner) or (owner or operator)

of the above-described well, being first duly sworn on oath, says: That I have knowledge of the facts, statements, and matters herein contained and the log of the above-described well as filed and that the same are true and correct. So help me God.

(Signature) J. P. Winterhalter 10/21/76  
P. O. Box 1337 Dodge City, Kansas 67801  
(Address)

SUBSCRIBED AND SWORN TO before me this 21st day of October, 1976



Linda L. Fletcher  
Linda L. Fletcher Notary Public.

My commission expires July 28, 1980