

15-057-00066-0000


STATE OF KANSAS
STATE CORPORATION COMMISSION

Give information Completely
Make Required Affidavit
Mail or Deliver Report to:
Conservation Division
State Corporation Commission
212 North Market, Insurance Bldg.
Wichita, Kansas

WELL PLUGGING RECORD

Ford County, Sec. 22 Twp. 26 Rge. 24 (E) (W) X
Location as "NE/CNW/SW" or footage from lines C SW NE
Lease Owner Raymond Oil Company, Inc.
Lease Name Conrardy Well No. #1
Office Address 410 Fourth National Bank Bldg., Wichita 2, Kansas
Character of Well (completed as Oil, Gas or Dry Hole) _____
Date well completed _____ 19____
Application for plugging filed _____ 19____
Application for plugging approved 2-26-62 19____
Plugging commenced 2-22-62 19____
Plugging completed 3-2-62 19____
Reason for abandonment of well or producing formation Dry
If a producing well is abandoned, date of last production _____ 19____
Was permission obtained from the Conservation Division or its agents before plugging was commenced? Yes

NORTH

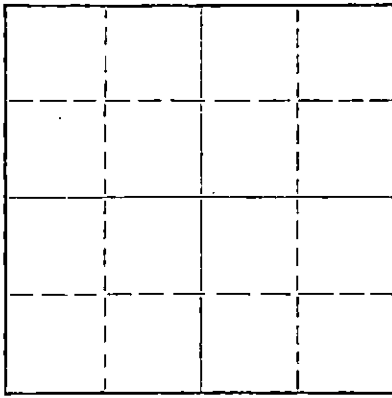

Locate well correctly on above Section Plat

Name of Conservation Agent who supervised plugging of this well W. L. Lackamp Jr.
Producing formation _____ Depth to top _____ Bottom _____ Total Depth of Well 5125' Feet
Show depth and thickness of all water, oil and gas formations.

OIL, GAS OR WATER RECORDS

CASING RECORD

FORMATION	CONTENT	FROM	TO	SIZE	PUT IN	PULLED OUT

Describe in detail the manner in which the well was plugged, indicating where the mud fluid was placed and the method or methods used in introducing it into the hole. If cement or other plugs were used, state the character of same and depth placed, from _____ feet to _____ feet for each plug set.
Sanded back to 4965' with 5 sacks cement thru dump baler.
Mudded hole to 450' and sat 10' rock bridge with 20 sacks cement.
Mudded hole to 40' and sat 10' rock bridge with 10 sacks cement to base of cellar

3-5-62
RECEIVED
STATE CORPORATION COMMISSION
MAR 5 1962
CONSERVATION DIVISION
WICHITA, KANSAS

(If additional description is necessary, use BACK of this sheet)
Name of Plugging Contractor Southwest Casing Pulling Co., Inc.
Address Box 364, Great Bend, Kansas

STATE OF Kansas, COUNTY OF Barton, ss.
Southwest Casing Pulling Co., Inc. (employee of owner) or (owner or operator) of the above-described well, being first duly sworn on oath, says: That I have knowledge of the facts, statements, and matters herein contained and the log of the above-described well as filed and that the same are true and correct. So help me God.

(Signature) W. C. Spencer, Sec. - Treas.
Box 364, Great Bend, Kansas
(Address)

SUBSCRIBED AND SWORN TO before me this 3 day of March, 19 62
Ernest D. Miller
Notary Public.

My commission expires 24 October 1964

