


STATE OF KANSAS
STATE CORPORATION COMMISSION

15-185-20850-0000

WELL PLUGGING RECORD

Give All Information Completely
Make Required Affidavit
Mail or Deliver Report to
Conservation Division
State Corporation Comm.
245 North Water
Wichita, KS 67202

Stafford County, Sec. 3 Twp. 25S Rge. 15W E7W
Location as "NE/CNW 1/4 SW 1/4" or footage from lines
C NW NE NW
Lease Owner Barnett Oil Company
Lease Name Barstow Well No. I-D
Office Address 1625 Vickers KSB&T Bldg., Wichita, KS
Character of Well (Completed as Oil, Gas or Dry Hole)
Dry Hole
Date Well completed 9-16 1978
Application for plugging filed 9-16 1978
Application for plugging approved 9-16 1978
Plugging commenced 9-16 1978
Plugging completed 9-16 1978
Reason for abandonment of well or producing formation

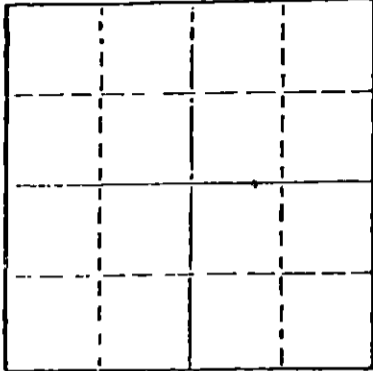

Locate well correctly on above
Section Plot

If a producing well is abandoned, date of last production 19

Was permission obtained from the Conservation Division or its agents before plugging was commenced? Yes

Name of Conservation Agent who supervised plugging of this well Bill Owen, Pratt, KS
Producing formation Depth to top Bottom Total Depth of Well 4430
Show depth and thickness of all water, oil and gas formations.

OIL, GAS OR WATER RECORDS

CASING RECORD

FORMATION	CONTENT	FROM	TO	SIZE	PUT IN	PULLED OUT

Describe in detail the manner in which the well was plugged, indicating where the mud fluid was placed and the method or methods used in introducing it into the hold. If cement or other plugs were used, state the character of same and depth placed, from feet to feet for each plug set.

Plugged as follows: Filled hole w/mud, spotted 50 sx @ 540'; mud to 330'; spotted 40 sx, mud to 40'; 1/2 sx hulls & wood plug for solid bridge; 12 sx to base of cellar; 3 sx in rat hole; completed @ 4:15 a.m. by Allied, used 50/50 pozmix; State Plugger - Bill Owen, Pratt, Kansas.

(If additional description is necessary, use BACK of this sheet)

Name of Plugging Contractor Husky Drilling Co., Inc.

STATE OF KANSAS COUNTY OF SEDGWICK, ss.
Jon T. Williams, Jr. (employee of owner) or (owner or operator)
of the above-described well, being first duly sworn on oath, says: That I have knowledge of the facts, statements, and matters herein contained and the log of the above-described well as filed and that the same are true and correct. So help me God.


(Signature)

800 Bitting Bldg., Wichita, KS 67202
(Address)

SUBSCRIBED AND SWORN TO before me this 16th day of September, 1978

Geraldine Stewart
Geraldine Stewart Notary Public.

My commission expires January 12, 1981

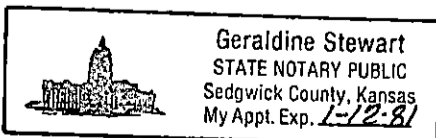



800 Bitting Bldg
Wichita, Kansas 67202
Phone 316 - 263-7904
Mobile Phone 316 - 793-7859 Unit 7070

15-185-20850-0000

September 20, 1978

WELL LOG.....Barstow D#1
Located: C NW NE NW, Section 3-25-15, Stafford,
County, Kansas

OWNER: Barnett Oil Company
ROTARY DRILLING CONTRACTOR: Husky Drilling Co., Inc.

COMMENCED: 9-08-78
COMPLETED: 9-16-78

TOTAL DEPTH: 4430'

LOG

CASING RECORD

0 - 40	Sand & Clay
40 - 340	Stone & Shale
340 - 480	Shale & Shells
480 - 780	Shale w/hard sand streaks
780 - 960	Shale & Sand
960 - 1675	Shale
1675 - 2055	Shale & Shells
2055 - 3290	Shale & Lime
3290 - 3564	Lime & Shale
3564 - 3745	Lime
3745 - 3974	Lime & Shale
3974 - 4102	Lime
4102 - 4370	Lime & Shale
4370 - 4430	Lime

Ran 8 jts., 8-5.8", 28#,
Rge 2 & 3, used casing, tallied
331.27', set @ 338'KB w/275
sx 60/40 pozmix w/2% Gel; 3%
cc - circulated - plug down @
7:45 p.m. 9-8-78 by Allied.

Plugged.