

15-185-11799-0000  
WELL PLUGGING RECORD


STATE OF KANSAS  
STATE CORPORATION COMMISSION

Give All Information Completely  
Make Required Affidavit  
Mail or Deliver Report to:  
Conservation Division  
State Corporation Commission  
800 Bittling Building  
Wichita, Kansas

~~FORMATION PLUGGING RECORD~~

Strike out upper line  
when reporting plug-  
ging of formations.

NORTH

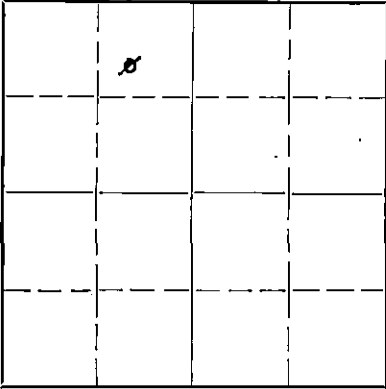

Locate well correctly on above  
Section Flat

Stafford County, Sec. 3 Twp. 25 Rge. 15 (W)  
Location as "NE $\frac{1}{4}$ NW $\frac{1}{4}$ SW $\frac{1}{4}$ " or footage from lines NE/4, NW/4, 990' fm Nth & East  
Lease Owner Sinclair Prairie Oil Co lines  
Lease Name Cora M. Smith Well No. 1  
Office Address Box 521, Tulsa 2, Okla.  
Character of Well (completed as Oil, Gas or Dry Hole) dry hole  
Date well completed August 28 19 43  
Application for plugging filed Sept. 8 19 43  
Application for plugging approved verbally Aug. 30 19 43  
Plugging commenced Aug. 30 19 43  
Plugging completed Aug. 31 19 43  
Reason for abandonment of well or producing formation completed as a dry hole

If a producing well is abandoned, date of last production - 19 -  
Was permission obtained from the Conservation Division or its agents before plugging was com-  
menced? yes, verbal permission by state field man

Name of Conservation Agent who supervised plugging of this well Ruel Durkee  
Producing formation Arbuckle Lime Depth to top 3364 Bottom - Total Depth of Well 4495 Feet  
Show depth and thickness of all water, oil and gas formations.

OIL, GAS OR WATER RECORDS

CASING RECORD

| Formation            | Content      | From        | To          | Size           | Put In     | Pulled Out |
|----------------------|--------------|-------------|-------------|----------------|------------|------------|
| <u>Arbuckle Lime</u> | <u>water</u> | <u>3364</u> | <u>4495</u> | <u>10-3/4"</u> | <u>967</u> | <u>0</u>   |
|                      |              |             |             |                |            |            |
|                      |              |             |             |                |            |            |
Describe in detail the manner in which the well was plugged, indicating where the mud fluid was placed and the method or methods used in introducing it into the hold. If cement or other plugs were used, state the character of same and depth placed, from \_\_\_\_\_ feet to \_\_\_\_\_ feet for each plug set.

- 4495 - 300' mud laden fluid
- 300 - set wooden plug
- 300 - 20' cement and set wooden plug at 20'
- 20 - to bottom of cellar

FILED  
3 25 15W  
89 3L

(If additional description is necessary, use BACK of this sheet)

Correspondence regarding this well should be addressed to Victor Chancellor  
Address Box 774, Great Bend, Kans.

STATE OF Kansas, COUNTY OF Barton, ss.  
I, Victor Chancellor (employee of owner) or (owner) of the above-described well,

being first duly sworn on oath, says: That I have knowledge of the facts, statements, and matters herein contained and the log of the above-described well as filed and that the same are true and correct. So help me God.

(Signature) Victor Chancellor 9-9-43  
Box 774, Great Bend, Kans.  
(Address)

SUBSCRIBED AND SWORN to before me this 8<sup>th</sup> day of September, 19 43  
J. W. Mair Farnase  
Notary Public.

My commission expires 6-14-47

Well Log

Cora M. Smith #1  
 SW NE NW, 3-25S-15W, Stafford Co., Kans.  
 990' fm North & East lines.  
 Elevation 2033'

Harbar Drilling Co., rotary  
 Began drlg Aug. 2, 1943  
 Completed drlg Aug. 28, 1943  
 T.D. 4495' in Arbuckle lime.  
 Dry hole..  
 Plugged & Abandoned 8-31-1943

Drillers Log

|                                   |         |
|-----------------------------------|---------|
| Sand                              | 220'    |
| Shale & Shells                    | 950     |
| Anhydrite                         | 980     |
| Set 10-3/4" at 959' w/450 sx cmt. |         |
| Shale & Shells                    | 1245    |
| Shale & Shells                    | 1700    |
| Salt                              | 1760    |
| Shale & Shells                    | 1820    |
| Lime                              | 2435    |
| Shale                             | 2485    |
| Lime                              | 2915    |
| Shale & Lime                      | 3015    |
| Lime & Shale                      | 3150    |
| Lime                              | 3170    |
| Lime & Shale                      | 3255    |
| Lime                              | 3290    |
| Lime & Shale                      | 3335    |
| Lime                              | 3435    |
| Lime-broken                       | 3460    |
| Lime                              | 3640    |
| Shale                             | 3780    |
| Lime                              | 3941    |
| Lime-soft                         | 3958    |
| Lime                              | 4160    |
| Shale                             | 4209    |
| Chert                             | 4215    |
| Shale                             | 4223    |
| Conglomerate                      | 4290    |
| Lime-cherty                       | 4318    |
| Chert                             | 4335    |
| Lime                              | 4440    |
| Shale                             | 4448    |
| Sand                              | 4450    |
| Shale                             | 4455    |
| Dolomite-Shale                    | 4460    |
| Lime                              | 4475    |
| Lime                              | 4495 TD |

9-9-43

| Meas..       | Rig Floor | - | Surface Level |
|--------------|-----------|---|---------------|
| Top Kas City | 3780      |   | 3777          |
| Conglomerate | 4170      |   | 4167          |
| Viola        | 4270      |   | 4267          |
| Arbuckle     | 4455      |   | 4452          |
| T.D.         | 4495      |   | 4492          |

Cored 4440-4450' recovered 9 ft. Simpson green shale 4440-48'  
 Cored 4450-4460' recovered 9 1/2' top 5' shale bottom 4 1/2' dolomite.  
 Cored 4460-4475' recovered 4 1/2' no show of oil. Spotted porosity.  
 Drilled to 4495' TD  
 Ran Schlumberger, no oil shows, show water in Lan-Ko & Arb.

3-25-15W  
 89-36

15-185-117990000

SMITH #1

In NE $\frac{1}{4}$  NW $\frac{1}{4}$  of Section 3-25S-15W, Stafford County, Kansas.

Rigging up Rotary Tools 7-30-43  
Tearing down Rotary Tools 9-2-43

Ran 31 Jts. 10 3/4" surface casing. Set @ 969'  
and cemented with 450 sacks of cement

| <u>FORMATION</u>  | <u>FROM</u> | <u>TO</u>        |
|-------------------|-------------|------------------|
| Cellar            | 0           | 10               |
| Sand              | 10          | 220              |
| Shale and shells  | 220         | 950              |
| Anhydrite         | 950         | 980              |
| Shale and shells  | 980         | 1700             |
| Salt              | 1700        | 1760             |
| Shale and shells  | 1760        | 1820             |
| Lime              | 1820        | 2435             |
| Shale             | 2435        | 2485             |
| Lime              | 2485        | 2915             |
| Shale and Lime    | 2915        | 3150             |
| Lime              | 3150        | 3170             |
| Shale and lime    | 3170        | 3255             |
| Lime              | 3255        | 3290             |
| Lime and shale    | 3290        | 3335             |
| Lime              | 3335        | 3435             |
| Broken Lime       | 3435        | 3460             |
| Lime              | 3460        | 3640             |
| Shale             | 3640        | 3780             |
| Lime              | 3780        | 3941             |
| Lime, soft        | 3941        | 3958             |
| Lime              | 3958        | 4160             |
| Shale             | 4160        | 4209             |
| Chert             | 4209        | 4215             |
| Shale             | 4215        | 4223             |
| Conglomerate      | 4223        | 4290             |
| Lime(Cherty)      | 4290        | 4318             |
| Chert, Very rough | 4318        | 4327             |
| Chert             | 4327        | 4335             |
| Lime              | 4335        | 4360             |
| Cherty Lime       | 4360        | 4368             |
| Lime              | 4368        | 4410             |
| Shale             | 4410        | 4440             |
| Cored shale       | 4440        | 4448             |
| Sand              | 4448        | 4455             |
| Cored Dolomite    | 4455        | 4460             |
| Lime              | 4460        | 4475             |
| Lime              | 4475        | 4495 Total Depth |

6-26-47  
JUN 26 1947

I, W. A. Grant, hereby certify that the above log is true and correct to the best of my knowledge.

Subscribed and sworn to before me, a Notary Public, this 24<sup>th</sup> day of June, 1947

Mary B. Brown  
Notary Public

My commission expires: Dec 23, 1950

PLUGGING  
FILE SEC-19-T-2LR-11W  
BOOK PAGE 21 LINE 1