


15-185-01169-0001

WELL PLUGGING RECORD

Give All Information Completely  
Make Required Affidavit  
Mail or Deliver Report to:  
Conservation Division  
State Corporation Commission  
212 No. Market  
Wichita, Kansas

Stafford County, Sec. 2 Twp. 25S Rge. (E) 15 (W)  
Location as "NE/CNW/SW" or footage from lines 330' FNL & 990' FWL  
Lease Owner Kewanee Oil Company  
Lease Name Barstow A Well No. 1-X  
Office Address P. O. Box 360, Hoisington, Kansas 67544  
Character of Well (completed as Oil, Gas or Dry Hole) Dry hole  
Date well completed Re-entry March 3, 19 67  
Application for plugging filed April 13, 19 67  
Application for plugging approved verbal 4-13-67 April 14, 19 67  
Plugging commenced April 13, 19 67  
Plugging completed April 13, 19 67  
Reason for abandonment of well or producing formation Dry Hole

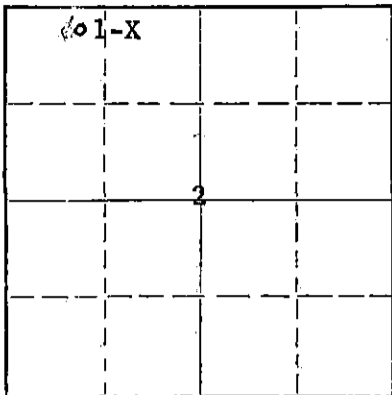

Locate well correctly on above  
Section Plat

If a producing well is abandoned, date of last production none 19       
Was permission obtained from the Conservation Division or its agents before plugging was commenced? Yes

Name of Conservation Agent who supervised plugging of this well A. Elving, Box 248, Pratt, Kansas  
Producing formation      Depth to top      Bottom      Total Depth of Well 2925' Feet  
Show depth and thickness of all water, oil and gas formations.

OIL, GAS OR WATER RECORDS

CASING RECORD

FORMATION	CONTENT	FROM	TO	SIZE	PUT IN	PULLED OUT
				8-5/8"	976'7"	None
<u>Re-entry of Skelly Oil Company's</u>				5-1/2"	4447'0"	None
<u>Franklin Barstow No. 1</u>						
<u>P &amp; A August 12, 1954.</u>						

Describe in detail the manner in which the well was plugged, indicating where the mud fluid was placed and the method or methods used in introducing it into the hole. If cement or other plugs were used, state the character of same and depth placed, from      feet to      feet for each plug set.

Set permanent bridge plug at 2575'.  
Dumped 2 sacks of cement.  
Water from top of cement to 300'.  
Set 5-1/2" cementing plug at 300'.  
10' of rock on top of plug.  
10 sacks of cement on top of rock.  
Top of cement @ 210'.  
Filled hole w/mud to 40'.  
Set 5-1/2" cementing plug w/  
10' rock and 4 sacks of cement.  
Cut 5-1/2" casing off 3' below G.L.  
Welded plate on 5-1/2" casing.  
plugged and abandoned @ 3:30 P.M.

RECEIVED  
STATE CORPORATION COMMISSION  
APR 19 1967  
4-19-67  
CONSERVATION DIVISION  
Wichita, Kansas

(If additional description is necessary, use BACK of this sheet)  
Name of Plugging Contractor Jamison Drilling Company  
Address Hoisington, Kansas 67544

STATE OF Kansas, COUNTY OF Sedgwick, ss.  
Bill Patton (employee of owner) or (owner or operator) of the above-described well, being first duly sworn on oath, says: That I have knowledge of the facts, statements, and matters herein contained and the log of the above-described well as filed and that the same are true and correct. So help me God.

(Signature) Bill Patton  
P. O. Box 360, Hoisington, Kansas 67544  
(Address)

SUBSCRIBED AND SWORN TO before me this 18th day of April, 19 67  
Sam B. McNeel  
Notary Public.

My commission expires August 2, 1969