


STATE OF KANSAS  
STATE CORPORATION COMMISSION  
Give All Information Completely  
Make Required Affidavit  
File or Deliver Report to:  
Conservation Division  
State Corporation Commission  
212 North Market, Insurance Bldg.  
Wichita, Kansas

WELL PLUGGING RECORD

Stafford County. Sec. 2 Twp. 25 Rge. 15 (E) W (W)  
Location as "NE/CNW%SW%" or footage from lines NW SW SW  
Lease Owner C-G Drilling  
Lease Name Barstow Well No. 1  
Office Address 107 Rule Bldg, Wichita, Kansas  
Character of Well (completed as Oil, Gas or Dry Hole) Dry hole  
Date well completed \_\_\_\_\_ 19\_\_\_\_  
Application for plugging filed \_\_\_\_\_ 19\_\_\_\_  
Application for plugging approved \_\_\_\_\_ 19\_\_\_\_  
Plugging commenced November 10 19 60  
Plugging completed November 16 19 60  
Reason for abandonment of well or producing formation No commercial  
production  
If a producing well is abandoned, date of last production \_\_\_\_\_ 19\_\_\_\_  
Was permission obtained from the Conservation Division or its agents before plugging was commenced? \_\_\_\_\_

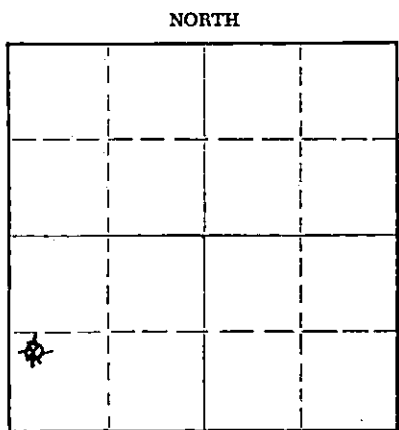

Locate well correctly on above Section Plat

Name of Conservation Agent who supervised plugging of this well Frank Broadfoot  
Producing formation \_\_\_\_\_ Depth to top \_\_\_\_\_ Bottom \_\_\_\_\_ Total Depth of Well 4470 Feet  
Show depth and thickness of all water, oil and gas formations.

OIL, GAS OR WATER RECORDS

CASING RECORD

FORMATION	CONTENT	FROM	TO	SIZE	PUT IN	PULLED OUT
				8"	286'	None
				5"	4467'	3338'

Describe in detail the manner in which the well was plugged, indicating where the mud fluid was placed and the method or methods used in introducing it into the hole. If cement or other plugs were used, state the character of same and depth placed, from \_\_\_\_\_ feet to \_\_\_\_\_ feet for each plug set.

Plugged with 10 feet chat and 5 sacks cement from 4470 to 4207'.  
Pumped 114 bbls. of rotary mud into annulus @ 400 lbs.  
Circulated mud @ 250' with 20 sacks of cement.  
Capped well with 10 sacks of cement.

RECEIVED  
STATE CORPORATION COMMISSION  
DEC 8 1960  
CONSERVATION DIVISION  
WICHITA, KANSAS


(If additional description is necessary, use BACK of this sheet)  
Name of Plugging Contractor Pipe Pullers, Inc.  
Address Box 486, Ellinwood, Kansas

STATE OF KANSAS, COUNTY OF SEDGWICK, ss.  
\_\_\_\_\_  
(employee of owner) or (owner or operator) of the above-described well, being first duly sworn on oath, says: That I have knowledge of the facts, statements, and matters herein contained and the log of the above-described well as filed and that the same are true and correct. So help me God.

(Signature) [Signature]

(Address) \_\_\_\_\_, 1960

SUBSCRIBED AND SWORN to before me this 19 day of November, 1960  
My commission expires May 20, 1963

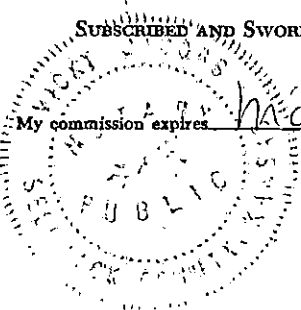

Notary Public.

*R*  
WELL LOG

OPERATOR C-G Drilling Co. & Houston Petroleum Co. SEC. 2-25-15W  
 WELL NAME Barstow "C" #1 LOC. NW SW SW  
 TOTAL DEPTH 4470' COUNTY Stafford  
 COMM. September 28, 1960 Plugged & Abandoned COMP. November 16, 1960 STATE Kansas  
 RIG NO. 2 ELEVATION 2022' K.B.

CASING: Ran 286.62' (14 jts.) 8-5/8" OD Surface PRODUCTION: D & A  
 Casing.  
 Set 5-1/2" OD Casing @4467' (137 jts.)  
 Pulled 3338'. Left 1129' in hole.

All measurements taken from the top of rotary bushing.

FROM	TO	FORMATION	DEVIATION FROM VERTICAL	REMARKS:
0	175	Sand		
175	285	Shale		
285	312	Shale-Shell		
312	650	Red Bed		
650	964	Sand		
964	982	Anhydrite		
982	1615	Shale-Shell	0° - 2500	
1615	3360	Shale-Lime	0° - 2750	DST 3905-3922'
3360	4329	Lime	0° - 3000	DST 4163-4193'
4329	4362	Lime-Chert	0° - 3250	DST 4193-4220'
4362	4470	Lime	0° - 3500	
			0° - 3750	
			0° - 4000	
			0° - 4250	

RECEIVED  
STATE CORPORATION COMMISSION

DEC 8 1960

CONSERVATION DIVISION  
Wichita, Kansas

12-8-60

STATE OF KANSAS }  
 COUNTY OF SEDGWICK } SS.

The undersigned hereby certifies that to the best of his knowledge and belief, the above facts are true and correct.

C-G DRILLING CO.

By *G. F. Galloway*  
 G. F. Galloway

SUBSCRIBED AND SWORN TO, BEFORE ME, THIS 7th day of December, 1960.

My commission expires:  
 May 20, 1963

*Vicky Jacobs*  
 Vicky Jacobs / Notary public

