

15-185-00369-0000

STATE OF KANSAS
STATE CORPORATION COMMISSION


Give All Information Completely
Make Required Affidavit
Mail or Deliver Report to:
Conservation Division
State Corporation Commission
211 No. Broadway
Wichita, Kansas

WELL PLUGGING RECORD

Sta fford County, Sec. 6 Twp. 25 Rge. 15 (E) (W)

Location as "NE/CNW/SW" or footage from lines NE NE SW
Lease Owner Aylward Drilling Company
Lease Name Knudsen Well No. 1
Office Address 813 1st Natl. Bank Bldg. - Wichita, Kansas
Character of Well (completed as Oil, Gas or Dry Hole) Dry Hole
Date well completed August 26 19 59
Application for plugging filed August 26 19 59
Application for plugging approved August 26 19 59
Plugging commenced August 26 19 59
Plugging completed August 26 19 59
Reason for abandonment of well or producing formation _____

NORTH

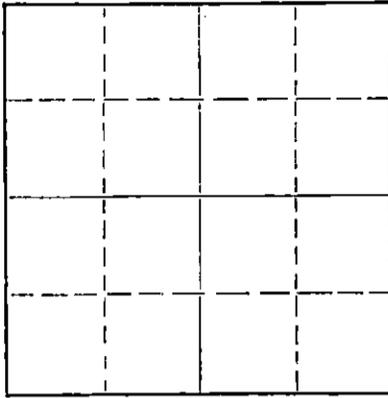

Locate well correctly on above
Section Plat

If a producing well is abandoned, date of last production _____ 19 _____
Was permission obtained from the Conservation Division or its agents before plugging was commenced? Yes

Name of Conservation Agent who supervised plugging of this well Frank Broadfoot - St. John, Kansas
Producing formation _____ Depth to top _____ Bottom _____ Total Depth of Well 4581' Feet
Show depth and thickness of all water, oil and gas formations.

OIL, GAS OR WATER RECORDS

CASING RECORD

FORMATION	CONTENT	FROM	TO	SIZE	PUT IN	PULLED OUT
				8 5/8"	230'	None

Describe in detail the manner in which the well was plugged, indicating where the mud fluid was placed and the method or methods used in introducing it into the hole. If cement or other plugs were used, state the character of same and depth placed, from _____ feet to _____ feet for each plug set.

Filled hole with heavy mud from total depth to 200'; set plug of 1/4 sack of hulls and 20 sacks of cement through drill pipe at 200'; heavy mud to 35'; set plug of 1/4 sack of hulls and 10 sacks of cement to top of surface pipe.

RECEIVED
STATE CORPORATION COMMISSION

JAN 21 1960

CONSERVATION DIVISION
Wichita Kansas

1-21-60

(If additional description is necessary, use BACK of this sheet)

Name of Plugging Contractor Aylward Drilling Company
Address 813 1st Natl. Bank Bldg. - Wichita, Kansas

STATE OF Kansas COUNTY OF Sedgwick, ss.
Paul W. Hesse (employee of owner) or (owner or operator) of the above-described well, being first duly sworn on oath, says: That I have knowledge of the facts, statements, and matters herein contained and the log of the above-described well as filed and that the same are true and correct. So help me God.

(Signature) Paul W. Hesse
813 1st Natl. Bank Bldg. - Wichita, Kansas
(Address)

SUBSCRIBED AND SWORN TO before me this 31st day of August, 19 59

My commission expires December 11, 1961

Duane Jessup
DUANE JESSUP Notary Public.



