


STATE OF KANSAS
STATE CORPORATION COMMISSION

WELL PLUGGING RECORD

Give All Information Completely
Make Required Affidavit
Mail or Deliver Report to
Conservation Division
State Corporation Comm.
245 North Water
Wichita, KS 67202

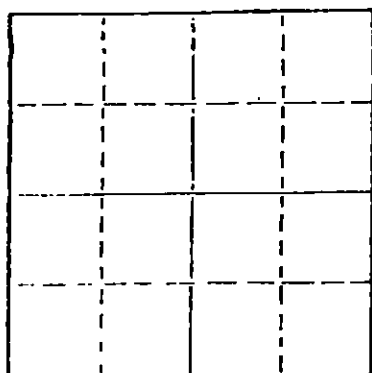

Locate well correctly on above
Section Plot

Stafford County. Sec. 36 Twp. 25S Rge. 14W E/W
Location as "NE/CNW $\frac{1}{4}$ SW $\frac{1}{4}$ " or footage from lines
NE SW SW

Lease Owner Dunne-Gardner Petroleum, Inc.
Lease Name Kachelman Well No. 1
Office Address Suite 250, 200 W. Douglas, Wichita, KS 67202
Character of Well (Completed as Oil, Gas or Dry Hole)

DRY HOLE

Date Well completed January 16, 1981
Application for plugging filed January 16, 1981
Application for plugging approved January 16, 1981
Plugging commenced January 16, 1981
Plugging completed January 16, 1981
Reason for abandonment of well or producing formation

DRY HOLE

If a producing well is abandoned, date of last production
19

Was permission obtained from the Conservation Division or
its agents before plugging was commenced? YES

Name of Conservation Agent who supervised plugging of this well Duane Rankins
Producing formation Depth to top Bottom Total Depth of Well 14,500'
Show depth and thickness of all water, oil and gas formations.

OIL, GAS OR WATER RECORDS

CASING RECORD

FORMATION	CONTENT	FROM	TO	SIZE	PUT IN	PULLED OUT
				8-5/8"	338'	

Describe in detail the manner in which the well was plugged, indicating where the mud fluid was placed and the method or methods used in introducing it into the hold. If cement or other plugs were used, state the character of same and depth placed, from feet to feet for each plug set.

Mud to 480', 50 sx cement
Mud to 338', 30 sx cement
Mud to 40', plug, 1/4 sacks hulls,
10 sx in rathole

(If additional description is necessary, use BACK of this sheet)

Name of Plugging Contractor

STATE OF Kansas COUNTY OF Sedgwick, ss.
Donald E. Hunt (Exploration) or (owner or operator)
of the above-described well, being first duly sworn on oath, says: That I have knowledge of the facts, statements, and matters herein contained and the log of the above-described well as filed and that the same are true and correct. So help me God.

(Signature)

Suite 250, 200 West Douglas, Wichita, Kansas
(Address)

SUBSCRIBED AND SWORN TO before me this 19th day of January, 1981

appointment

My commission expires March 1, 1982

Notary Public.

15-185-21205-0000

DRILLERS LOG

#1 KACHELMAN
NE SW SW Section 36-25S-14W
Stafford County, Kansas

OPERATOR: DUNNE-GARDNER PETROLEUM, INC.
Suite 250, 200 West Douglas
Wichita, Kansas 67202

CONTRACTOR: DUNNE-GARDNER PETROLEUM, INC.
Suite 250, 200 West Douglas
Wichita, Kansas 67202

COMMENCED: January 7, 1981

COMPLETED: January 16, 1981

CASING RECORD: 8-5/8' @ 338' w/250 sx

<u>FROM</u>	<u>TO</u>	<u>DESCRIPTION</u>
0	347	Sand
347	900	Sand, shale and shells
900	1075	Anhydrite
1075	2390	Lime and shale
2390	2860	Lime
2860	4224	Lime and shale
4224	4331	Lime
4331	4340	Shale
4340	4500	Lime and shale
4500		Rotary total depth

STATE OF KANSAS)
) ss
COUNTY OF SEDGWICK)

I hereby certify that the above is a true and correct log to the best of my knowledge and belief.

Donald E. Hunt
Donald E. Hunt

Subscribed and sworn to before me this 19th day of January, 1981.

My appointment expires:
March 1, 1982

Dorothy M. Michail
Notary Public



STATE OF KANSAS
JAN 29 1981
1-29-81
CONSERVATION COMMISSION
Wichita, Kansas