


WELL PLUGGING RECORD 15-047-70018-0000

Give All Information Completely
Make Required Affidavit
Mail or Deliver Report to:
Conservation Division
State Corporation Commission
212 No. Market
Wichita, Kansas

NORTH

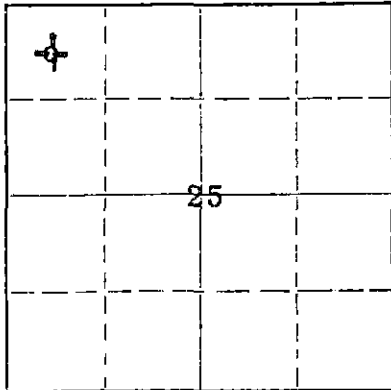

Locate well correctly on above
Section Plat

Edwards County. Sec 25 Twp. 26S Rge. 18W NE (W)
Location as "NE/CNW/SW" or footage from lines C NW NW
Lease Owner Southland Royalty Company
Lease Name V. C. Brown Well No. 1
Office Address 1405 Wilco Bldg., Midland, Texas
Character of Well (completed as Oil, Gas or Dry Hole) Dry Hole
Date well completed November 19, 1967
Application for plugging filed November 19, 1967
Application for plugging approved November 19, 1967
Plugging commenced November 19, 1967
Plugging completed November 19, 1967
Reason for abandonment of well or producing formation Dry Hole

If a producing well is abandoned, date of last production _____ 19____
Was permission obtained from the Conservation Division or its agents before plugging was commenced? Yes

Name of Conservation Agent who supervised plugging of this well Archie Elving
Producing formation _____ Depth to top _____ Bottom _____ Total Depth of Well 3318 Feet
Show depth and thickness of all water, oil and gas formations.

OIL, GAS OR WATER RECORDS

CASING RECORD

FORMATION	CONTENT	FROM	TO	SIZE	PUT IN	PULLED OUT
		0'	290'	8-5/8"	290'	None

Describe in detail the manner in which the well was plugged, indicating where the mud fluid was placed and the method or methods used in introducing it into the hole. If cement or other plugs were used, state the character of same and depth placed, from _____ feet to _____ feet for each plug set.

3318'-300' Mud
300'-296' Plug
296'-256' Cement, 35 sacks
256'-40' Mud
40'-36' Plug
36'-6' Cement, 10 sacks (Bottom of Cellar)

RECEIVED
STATE CORPORATION COMMISSION
NOV 27 1967
CONSERVATION DIVISION
Wichita, Kansas

(If additional description is necessary, use BACK of this sheet)

Name of Plugging Contractor Lauck Drilling Company, Incorporated
Address 301 S. Broadway, Wichita, Kansas

STATE OF KANSAS, COUNTY OF SEDGWICK, ss.

John H. Knightley (employee of owner) or (owner or operator) of the above-described well, being first duly sworn on oath, says: That I have knowledge of the facts, statements, and matters herein contained and the log of the above-described well as filed and that the same are true and correct. So help me God.

(Signature) John H. Knightley
301 S. Broadway, Wichita, Kansas
(Address)

SUBSCRIBED AND SWORN TO before me this 22nd day of November, 19 67

My commission expires March 12, 1971

Stella J. Lipps
Notary Public.

Southland Royalty Company

15-047-20018-0000

V. C. Brown #1

C NW NW Sec. 25-26S-18W
Edwards County, Kansas

Commenced: November 13, 1967
Completed: November 19, 1967

Rotary Drilling Contractor: Lauck Drilling Company, Incorporated.

Casing Record: 290' 8-5/8" Cemented with 200 sacks Cement,
4 sacks Calcium Chloride.

Elevation: GL 2162; DF 2165; KB 2167.

Drillers Log

Sand	195
Sand & Shale	225
Shale	470
Sand	520
Sand & Red Bed	560
Red Bed	1177
Anhydrite	1250
Shale & Shells	2150
Lime & Shale	3239
Sand	3268
Shale	3272
Shale & Lime	3318 RTD

RECEIVED
STATE DEPARTMENT OF REVENUE
NOV 27 1967
CONSERVATION DIVISION
Wichita, Kansas