


Give All Information Completely
Make Required Affidavit
Mail or Deliver Report to:
Conservation Division
State Corporation Commission
211 No. Broadway
Wichita, Kansas

WELL PLUGGING RECORD 15-047-002720000

NORTH

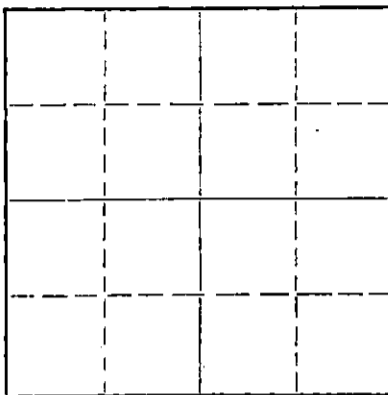

Locate well correctly on above
Section Plat

Edwards County, Sec. 29 Twp. 26S Rge. 18W (E) (W)
Location as "NE/CNW/SW" or footage from lines C SE NW
Lease Owner Kenneth Rupp
Lease Name O'Connor-Gamble Unit Well No. 1
Office Address 1035 Wichita Plaza, Wichita, Kansas
Character of Well (completed as Oil, Gas or Dry Hole) D & A
Date well completed December 18, 19 63
Application for plugging filed December 18, 19 63
Application for plugging approved December 18, 19 63
Plugging commenced December 18, 19 63
Plugging completed December 18, 19 63
Reason for abandonment of well or producing formation D & A

If a producing well is abandoned, date of last production 19
Was permission obtained from the Conservation Division or its agents before plugging was commenced? Yes

Name of Conservation Agent who supervised plugging of this well Archie V. Elving
Producing formation _____ Depth to top _____ Bottom _____ Total Depth of Well 4811 Feet
Show depth and thickness of all water, oil and gas formations.

OIL, GAS OR WATER RECORDS

CASING RECORD

FORMATION	CONTENT	FROM	TO	SIZE	PUT IN	PULLED OUT
				8 5/8"	281'	-0-

Describe in detail the manner in which the well was plugged, indicating where the mud fluid was placed and the method or methods used in introducing it into the hole. If cement or other plugs were used, state the character of same and depth placed, from _____ feet to _____ feet for each plug set.

Pushed plug to 275',
cement w/25 sx. through
drill pipe. Mud to 40',
1/2 sx hulls, plug, 10 sx.
through drill pipe, 2 sx.
in rathole.

RECEIVED
STATE CORPORATION COMMISSION

DEC 27 1963

CONSERVATION DIVISION
Wichita, Kansas

(If additional description is necessary, use BACK of this sheet)

Name of Plugging Contractor Red Tiger Drilling Company
Address Box 173 -- Russell, Kansas

STATE OF Kansas, COUNTY OF Sedgwick, ss.
George A. Angle (owner or operator) of the above-described well, being first duly sworn on oath, says: That I have knowledge of the facts, statements, and matters herein contained and the log of the above-described well as filed and that the same are true and correct. So help me God.

(Signature) George A. Angle
1720 Wichita Plaza, Wichita, Kansas
(Address)

SUBSCRIBED AND SWORN TO before me this 20th day of December, 1963

Wesley V. Head
Notary Public.

My commission expires 11-17-66

15-017-00272-0000

DRILLERS LOG

#1 O'Connor

CASING RECORD: 8 5/8" @ 281' w/200 sx cement

COMPANY: Kenneth Rupp

CONTRACTOR: Red Tiger Drilling Co.

COMMENCED: December 5, 1963

COMPLETED: December 18, 1963

DESCRIPTION: C SE NW 29-26S-18W Edwards Co., Kansas

ELEVATION: 2197 DF 2200 RB

TOTAL DEPTH: 4811'

<u>FORMATION</u>	<u>FROM</u>	<u>TO</u>	<u>REMARKS</u>
Sand Gravel & Clay Streaks	0	228	
Shale	228	575	
Shale & Shells	575	682	
Lime	682	691	
Redbed & Shale	691	1264	
Anhydrite	1264	1292	
Shale & Shells	1292	1985	
Shale & Lime Shells	1985	2315	
Shale & Lime	2315	3695	
Lime	3695	3870	
Lime & Shale	3870	4180	
Lime	4180	4660	
Lime & Shale	4660	4811	

RECEIVED
STATE CORPORATION COMMISSION
DEC 27 1963
CONSERVATION DIVISION
Wichita, Kansas

I certify that this is a true and correct copy of the above log to the best of my knowledge.

RED TIGER DRILLING COMPANY

George A. Angle
George A. Angle

Subscribed and sworn to before me this 20th day of December, 1963.

Dwayne V. Head
Notary Public

My Commission Expires:
11-17-66

RECEIVED
STATE CORPORATION COMMISSION
DEC 27 1963
CONSERVATION DIVISION
Wichita, Kansas