

15-647-10045-0000


WELL PLUGGING RECORD

Give All Information Completely
Make Required Affidavit
Mail or Deliver Report to:
Conservation Division
State Corporation Commission
800 Bitting Building
Wichita, Kansas

Edwards County. Sec. 33 Twp. 26 Rge. 18 (E) (W)

Location as "NE/CNW*SW*" or footage from lines SE NE SW
Lease Owner H. W. Muir and Ben M. Giles
Lease Name Welsh Well No. 1
Office Address 2727 Main Street, Hutchinson, Kansas
Character of Well (completed as Oil, Gas or Dry Hole) Dry Hole
Date well completed September 10 19 55
Application for plugging filed September 10 19 55
Application for plugging approved September 10 19 55
Plugging commenced 10:00 pm September 10 19 55
Plugging completed 2:00 am September 11 19 55
Reason for abandonment of well or producing formation Dry Hole

NORTH

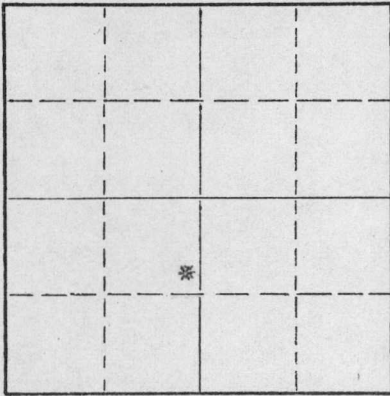

Locate well correctly on above Section Plat

If a producing well is abandoned, date of last production _____ 19____
Was permission obtained from the Conservation Division or its agents before plugging was commenced? Yes

Name of Conservation Agent who supervised plugging of this well Warren Horner
Producing formation _____ Depth to top _____ Bottom _____ Total Depth of Well 4782 Feet
Show depth and thickness of all water, oil and gas formations.

OIL, GAS OR WATER RECORDS

CASING RECORD

FORMATION	CONTENT	FROM	TO	SIZE	PUT IN	PULLED OUT
Surface pipe		0	290	8 5/8	290	0

Describe in detail the manner in which the well was plugged, indicating where the mud fluid was placed and the method or methods used in introducing it into the hole. If cement or other plugs were used, state the character of same and depth placed, from _____ feet to _____ feet for each plug set.

Filled with heavy mud to 280'
Set plug with 1/3 sack hulls under at 280'
Drove plug down with DP
Poured 20 sacks cement on top plug through DP
Filled with heavy mud to 40' and set plug
Filled with cement to bottom of cellar.

(If additional description is necessary, use BACK of this sheet)

Name of Plugging Contractor A. L. Jackson Drilling Company
Address Box 194, Great Bend, Kansas

STATE OF Kansas, COUNTY OF Barton, ss.
Dick B. Evans, accountant for _____ (employee of owner) or ~~(owner or operator)~~ of the above-described well, being first duly sworn on oath, says: That I have knowledge of the facts, statements, and matters herein contained and the log of the above-described well as filed and that the same are true and correct. So help me God.

(Signature) Dick B. Evans
Box 194, Great Bend, Kansas
(Address)

SUBSCRIBED AND SWORN TO before me this 13th day of September, 19 55

My commission expires April 27, 1957

Vigil L. [Signature]
Notary Public.

PLUGGING
FILE SEC. 33 T. 26 R. 18 W.
BOOK PAGE 149 LINE 14



RECEIVED
STATE CORPORATION COMMISSION
SEP 17 1955
CONSERVATION DIVISION
Wichita, Kansas

Well Log
 Welsh # 1
 SE NE SW 33-26-18
 Edwards County, Kansas

15-047-10045-0000

0-80	Sand
80 - 130	Shale and sand
130 - 235	Sand
235 - 280	Blue shale and sand streaks
280 - 465	Blue shale
465 - 495	Gray shale and sand
495 - 515	Sand
515 - 540	Red bed
540 - 590	Red bed and shells
590 - 980	Red and gray shale and shells
980 - 1040	Sand-hard
1040 - 1155	Red bed, shells, black shale
1155 - 1195	Red bed, shale
1195 - 1230	Sand and shale
1230 - 1700	Shale, shells and red bed
1700 - 1800	Salt - red bed shale
1800 - 1820	Red bed, shale and shells
1820 - 2120	Shale and shells
2120 - 2160	Shale, lime and shells
2160 - 2240	Shale
2240 - 2270	Lime, shale, shells
2270 - 2295	Shells and shale
2295 - 2400	Anhydrite, shells and shale
2400 - 2465	Sandy lime and shale
2465 - 2485	Sand-shale
2485 - 2520	Shale-lime-sand
2520 - 2650	Lime and shale - Fort Riley
2650 - 2680	Sandy lime and shale
2680 - 2790	Lime and shale
2790 - 2920	Lime, sand and shale
2920 - 3010	Lime and shale
3010 - 3185	Lime, sand and shale
3185 - 3290	Lime and shale
3290 - 3390	Shale, lime and sand
3390 - 3450	Lime and shale
3450 - 3530	Lime
3530 - 3540	Shale
3540 - 3580	Lime and shale
3580 - 3705	Lime
3705 - 3930	Lime and shale
3930 - 3985	Lime, sandy-shale
3985 - 3999	Sand and lime
3999 - 4025	Shale and lime
4025 - 4110	Douglas shale-lime
4110 - 4175	Lime-shale Lansing - K. C.
4175 - 4225	Lansing
4225 - 4485	Lime
4485 - 4535	Lime and shale
4535 - 4580	Lime and shale breaks
4580 - 4750	Shale and lime
4750 - 4775	Lime-shale Viola
4775 - 4782	Viola lime
4782	TD

STATE OF KANSAS
 COUNTY OF BARTON ss

RECEIVED
 STATE CORPORATION COMMISSION
 17 1955
 OBSERVATION DIVISION
 Wichita, Kansas

Dick B. Evans, accountant for A. L. Jackson Drilling Company, being first duly sworn on oath, says: That I have knowledge of the facts, statements, and matters herein contained and the log of the above described well as filed and that the same are true and correct.

PLUGGING
 FILED SEC 33 T 26 R 180
 BOOK PAGE 149 LINE 14

Dick B. Evans
 Dick B. Evans
 Box 194
 Great Bend, Kansas

Subscribed and sworn to before me this 13th day of September, 1955.

Virgil E. Kelly

My Commission Expires April 27, 1957.