

STATE OF KANSAS
STATE CORPORATION COMMISSION


Form CP-4

Give All Information Completely
Make Required Affidavit
Mail or Deliver Report to:
Conservation Division
State Corporation Commission
212 No. Market
Wichita, Kansas

WELL PLUGGING RECORD

Edwards County, Sec. 14 Twp. 26 Rge. 19 (E) W (W)
Location as "NE/CNW/SW" or footage from lines NW NE NW

Lease Owner Glen Rupe
Lease Name Taylor Well No. #1
Office Address 222 Brown Bldg. Wichita, Kansas
Character of Well (completed as Oil, Gas or Dry Hole) _____
Date well completed _____ 19____
Application for plugging filed November 1969
Application for plugging approved November 1969
Plugging commenced December 15 1969
Plugging completed December 18 1969
Reason for abandonment of well or producing formation _____

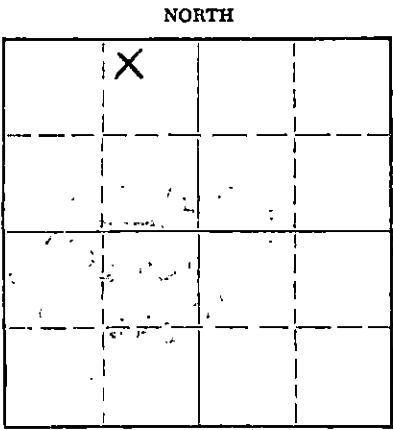

Locate well correctly on above Section Plat

If a producing well is abandoned, date of last production _____ 19____
Was permission obtained from the Conservation Division or its agents before plugging was commenced? Yes

Name of Conservation Agent who supervised plugging of this well Herman Justis
Producing formation _____ Depth to top _____ Bottom _____ Total Depth of Well _____ Feet
Show depth and thickness of all water, oil and gas formations.

OIL, GAS OR WATER RECORDS

CASING RECORD

FORMATION	FROM	TO	SIZE	PUT IN	PULLED OUT
			8 5/8	250	None
			5 1/2	4726	2521

RECEIVED
STATE CORPORATION COMMISSION
JAN 26 1970
CONSERVATION DIVISION
Wichita, Kansas

Describe in detail the manner in which the well was plugged, indicating where the mud fluid was placed and the method or methods used in introducing it into the hole. If cement or other plugs were used, state the character of same and depth placed, from _____ feet to _____ feet for each plug set.

December 15, 1969 Dumped sand to 4675'. Mixed and dumped 5 sx of cement to 4635'

December 18, 1969 Set 10' rock bridge from 240' to 230'. Mixed and dumped 25 sx of cement from 230' to 155'. Filled 8 5/8" casing with mud to 40'. Set 10' rock bridge from 40' to 30'. Mixed and dumped 10 sx of cement from 30' to base of cellar.

(If additional description is necessary, use BACK of this sheet)
Name of Plugging Contractor RUSS CASING PULLING, INC.
Address P. O. BOX 1082 GREAT BEND, KANSAS 67530

STATE OF Kansas, COUNTY OF Sedgwick, ss.
Glen N. Rupe (Employee or Owner) or (Owner or operator) of the above-described

well, being first duly sworn on oath, says: That I have knowledge of the facts, statements, and matters herein contained and the log of the above-described well filed and that the same are true and correct. So help me God.

(Signature) Glen N. Rupe
Glen N. Rupe
222 Brown Building, Wichita, Kansas

SUBSCRIBED AND SWORN TO before me this 31st day of December, 1969

My commission expires Sept. 16, 1973
Faye W. Leach
Faye W. Leach Notary Public.

Driller's Log

15-047-20030-0000

COMPANY
CONTRACTOR
FARM
LOCATION

Glen Rupe
Leben Drilling, Inc.
Taylor #1
NE NW NW Section 14-26S-19W
Edwards County, Kansas
6-17-68
6-26-68

NW 1/4

COMMENCED
COMPLETED

RECEIVED
STATE CORPORATION COMMISSION
DEC 23 1969
CONSERVATION DIVISION
Wichita, Kansas

0	175	Sand
175	327	Shale
327	721	Shale and Red Bed
721	740	Anhydrite
740	1296	Shale, Red Bed
1296	1314	Anhydrite
1314	1633	Shale
1633	2300	Shale, Lime
2300	2740	Lime, Shale
2740	2910	Lime
2910	3290	Lime, Shale
3290	3530	Sand, Shale, Lime
3530	3663	Shale, Lime
3663	3997	Lime, Shale
3997	4140	Shale
4140	4182	Lime
4182	4264	Lime, Shale
4264	4486	Lime
4486	4640	Lime, Shale
4640	4725	Lime
4725	4742	Chert
	<u>4742</u>	<u>RTD - Set 5 1/2" Csg.</u>

8 5/8" New 20# surface casing Set @ 250' with 275 ex common 2% cc

I, Leslie Kite, do hereby certify that the above and foregoing is a true and correct copy of the log of the Taylor #1 Well, located NE NW NW of Section 14, Township 26 South, Range 19 West, Edwards County, Kansas, as reflected by the records of Leben Drilling, Inc.

Leslie Kite
Leslie Kite

STATE OF KANSAS
COUNTY OF BARTON SS

Subscribed and sworn to and before me, a Notary Public, in and for Barton County, Kansas, this 26th day of June, 1968

Ulanda Nichols

My Commission Expires:
April 1, 1971